

Application for Minor VarianceSection 45 of the *Planning Act*, R.S.O. 1990 c.P.13

Please Note: You are receiving this notice as you are within 60 meters of the subject property.

Application Number: A-2024-0213
Property Address: 201 Bufford Drive
Legal Description: Plan M688, Lot 12, Ward 3
Agent: Noble Prime Solutions
Owner(s): Soni Rose Mathew, Rony Kandathimakla Baby
Other applications: nil
under the *Planning Act*

Meeting Date and Time: Tuesday, July 16, 2024, at 9:30 am
Meeting Location: Hybrid in-person and virtual meeting – Council Chambers,
4th Floor Brampton City Hall, 2 Wellington Street West

Purpose of the Application:

1. To permit an existing above grade entrance in a side yard having a minimum width of 0.93 metres extending from the front wall of the dwelling up to the door, whereas the by-law permits an above grade entrance when the side yard within which the door is located has a minimum width of 1.2 metres (3.94 feet) extending from the front wall of the dwelling up to and including the door.

Participate in the Meeting:

- Send an email with your written comments to coa@brampton.ca. Written submissions must include your name and mailing address, the application number or property address you are commenting on, along with authorization to post your correspondence on the agenda and must be received no later than **4:00 pm on Thursday, July 11, 2024**.
- Participate in person by attending the meeting on the date and time noted above. You are encouraged to register for in person attendance by emailing coa@brampton.ca and indicating if you plan to address Committee.
- Participate virtually (computer, tablet or smartphone). To participate virtually via WebEx, you must register in advance, no later than **4:00 pm on Thursday, July 11, 2024**, by emailing coa@brampton.ca, and providing your name, mailing address, phone number and email address. Confirmation of registration and participation instructions will be provided.

Note: Information provided in your correspondence, virtual or in-person delegation will become part of the public meeting record and will be posted on the City's website. If you do not participate in the public meeting, Committee may make a decision in your absence, and you will not be entitled to any further notice in the proceedings.

Viewing Application Materials: The application and related materials are available online at www.brampton.ca/en/city-hall/meetings-agendas and may be viewed in person in the City Clerk's Office during regular business hours. More information regarding the Committee of Adjustment is available at www.brampton.ca.

Appeal Process: If you wish to be notified of the decision of Committee, you must submit a written request to coa@brampton.ca. This will also entitle you to be advised of an appeal of the matter to the Ontario Land Tribunal (OLT). Please be advised that only the applicant, municipality, certain public bodies and the Minister can appeal a decision to the OLT. If a decision is appealed, you may request participant status by contacting olt.clo@ontario.ca.


Owners are requested to ensure that their tenant(s) are notified of this application and meeting date. This notice is to be posted by the owner of any land that contains seven or more residential units in a location that is visible to all of the residents.

Dated this 2nd day of July 2024

Secretary Treasurer
Committee of Adjustment, City Clerk's Office
2 Wellington Street West, Brampton, L6Y 4R2
P: 905.874.2117
E: coa@brampton.ca

MINOR VARIANCE

- TO PERMIT AN ABOVE GRADE SIDE DOOR IN SIDE YARD WITHOUT CLEAR ACCESS OF 1.2m LEADING TO IT;
- TO PERMIT A SIDE DOOR IN THE INTERIOR SIDE YARD HAVING A SETBACK OF 0.93 M WHEREAS ZONING BY-LAW REQUIRES A MINIMUM SETBACK OF 1.2 M FROM INTERIOR SIDE LOT LINE.

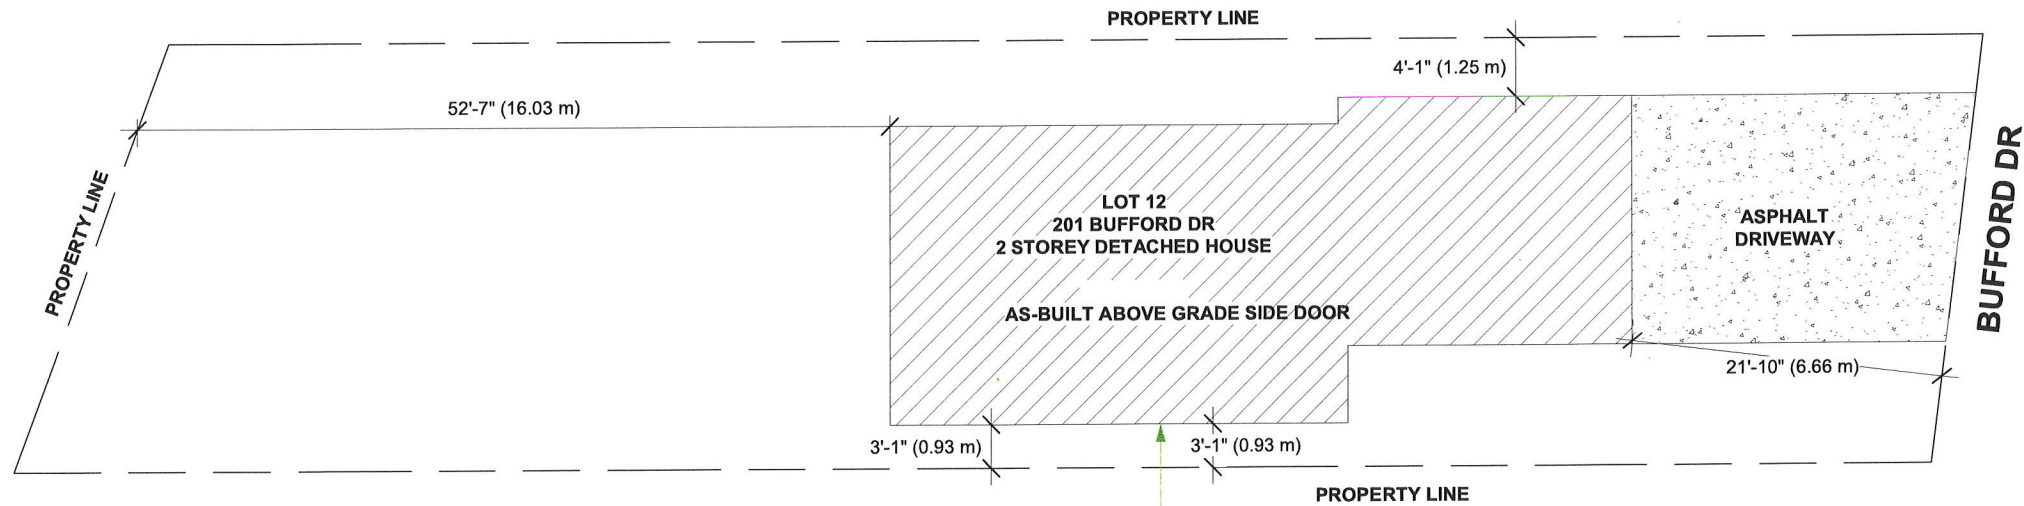

**AS-BUILT ABOVE GRADE ENTRANCE
(ON GRADE LEVEL)**

(NOT TO BE USED AS PRIMARY ENTRY AND EXIT FOR SECOND DWELLING UNIT)

SITE PLAN

THE CONTRACTOR MUST VERIFY AND ACCEPT RESPONSIBILITY FOR ALL DIMENSIONS AND CONDITIONS ON SITE AND MUST NOTIFY THE DESIGNER/ENGINEER OF ANY VARIATIONS FROM THE SUPPLIED INFORMATION.
CONSTRUCTION MUST CONFORM TO ALL APPLICABLE CODES AND REQUIREMENTS OF AUTHORITIES HAVING JURISDICTION.

STAMP

01 ISSUED FOR VARIANCE MAY 03/24

ADDRESS:
201 BUFFORD DR,
BRAMPTON, ON

DRAWN BY: NK CHECKED BY: TR
PROJECT NUMBER: 24R-29965

NOBLE PRIME SOLUTIONS LTD
2131 WILLIAMS PARKWAY
UNIT 19,
BRAMPTON, ON
info@nobletd.ca
(437) 888 1800

DATE: MAY 03/24 DWG No: A-1
SCALE: 1" = 10'-0"