

**Application for Minor Variance**Section 45 of the *Planning Act*, R.S.O. 1990 c.P.13**Please Note:** You are receiving this notice as you are within 60 meters of the subject property.

**Application Number:** A-2024-0395  
**Property Address:** 21 Bramfield Street  
**Legal Description:** Plan M1504, Lot 112, Ward 6  
**Agent:**  
**Owner(s):** Sunny Nagah, Ishani Gandhar  
**Other applications:** nil  
**under the *Planning Act***

**Meeting Date and Time:** Tuesday, November 12, 2024, at 9:30 am  
**Meeting Location:** Hybrid in-person and virtual meeting – Council Chambers,  
4<sup>th</sup> Floor Brampton City Hall, 2 Wellington Street West

**Purpose of the Application:**

1. To permit a parking space depth of 3.03 metres, whereas the by-law requires a minimum parking space depth of 5.4 metres.

**Participate in the Meeting:**

- Send an email with your written comments to [coa@brampton.ca](mailto:coa@brampton.ca). Written submissions must include your name and mailing address, the application number or property address you are commenting on, along with authorization to post your correspondence on the agenda and must be received no later than **12:00 pm on Thursday, November 7, 2024**.
- Participate in person by attending the meeting on the date and time noted above. You are encouraged to register for in person attendance by emailing [coa@brampton.ca](mailto:coa@brampton.ca) and indicating if you plan to address Committee.
- Participate virtually (computer, tablet or smartphone). To participate virtually via WebEx, you must register in advance, no later than **12:00 pm on Thursday, November 7, 2024**, by emailing [coa@brampton.ca](mailto:coa@brampton.ca), and providing your name, mailing address, phone number and email address. Confirmation of registration and participation instructions will be provided.

**Note:** Information provided in your correspondence, virtual or in-person delegation will become part of the public meeting record and will be posted on the City's website. If you do not participate in the public meeting, Committee may make a decision in your absence, and you will not be entitled to any further notice in the proceedings.


**Viewing Application Materials:** The application and related materials are available online at [www.brampton.ca/en/city-hall/meetings-agendas](http://www.brampton.ca/en/city-hall/meetings-agendas) and may be viewed in person in the City Clerk's Office during regular business hours. More information regarding the Committee of Adjustment is available at [www.brampton.ca](http://www.brampton.ca).

**Appeal Process:** If you wish to be notified of the decision of Committee, you must submit a written request to [coa@brampton.ca](mailto:coa@brampton.ca). This will also entitle you to be advised of an appeal of the matter to the Ontario Land Tribunal (OLT). Please be advised that only the applicant, municipality, certain public bodies and the Minister can appeal a decision to the OLT. If a decision is appealed, you may request participant status by contacting [olt.clo@ontario.ca](mailto:olt.clo@ontario.ca).

Owners are requested to ensure that their tenant(s) are notified of this application and meeting date. This notice is to be posted by the owner of any land that contains seven or more residential units in a location that is visible to all of the residents.

Dated this 30th day of October 2024

Secretary Treasurer  
Committee of Adjustment, City Clerk's Office  
2 Wellington Street West, Brampton, L6Y 4R2  
E: [coa@brampton.ca](mailto:coa@brampton.ca)

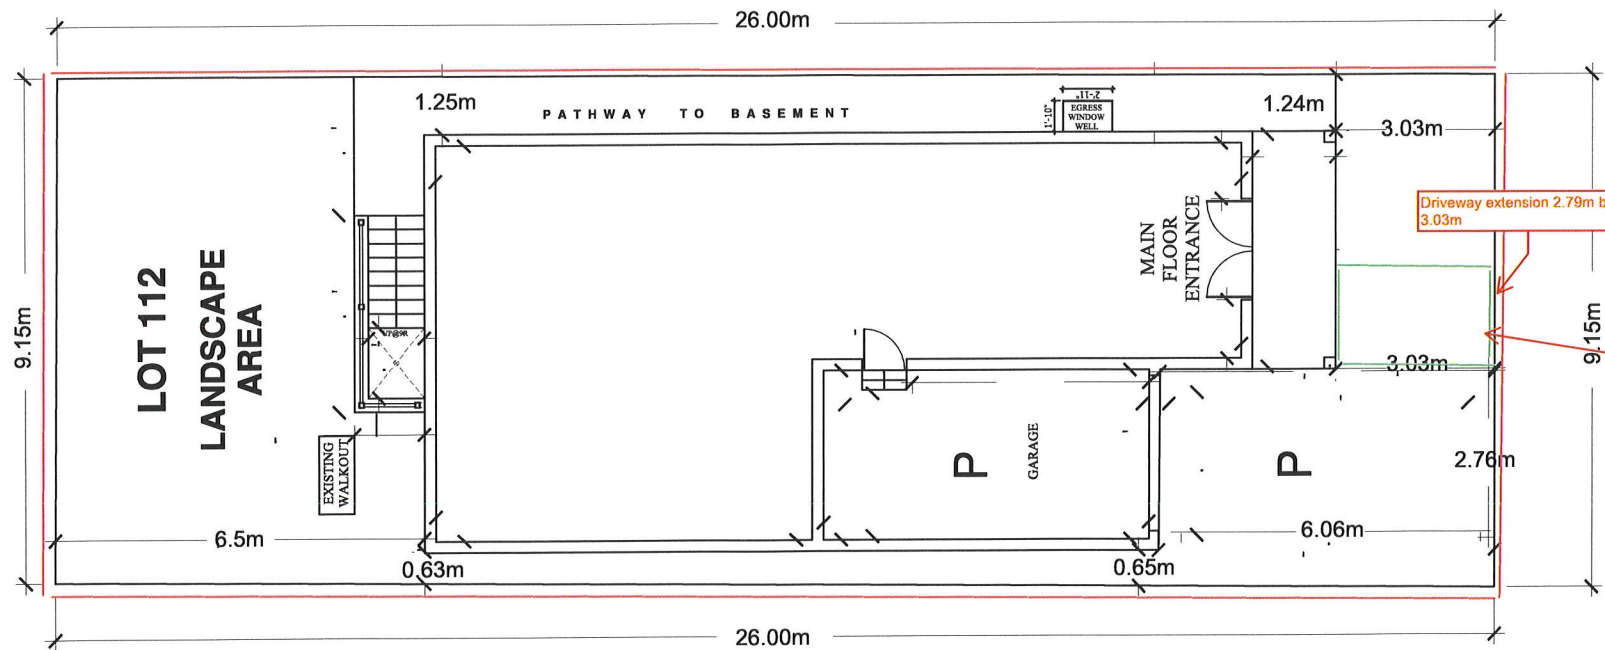

**SITE PLAN**



**21 BRAMFIELD STREET**

GENERAL NOTES

DO NOT SCALE DRAWINGS  
 PROPERTY RIGHTS RETAINED BY:  
 BG CONSTRUCTION DESIGN  
 ANY REPRODUCTION IN WHOLE OR IN PART  
 UNDER THE RULES AND BY-LAWS OF THE  
 CORPORATION IS STRICTLY FORBIDDEN.  
 ANY REPRODUCTIONS MUST BE  
 AUTHORIZED BY  
 ALL DRAWINGS ARE IN METRIC SCALE

SCOPE OF WORK

THE UNDERSIGNED HAS REVIEWED AND  
 TAKES RESPONSIBILITY FOR THIS DESIGN,  
 AND HAS THE QUALIFICATIONS AND  
 MEETS THE REQUIREMENTS SET OUT  
 IN THE ONTARIO BUILDING CODE  
 TO BE A DESIGNER.

QUALIFICATION INFORMATION  
 REQUIRED UNLESS DESIGN IS EXEMPT  
 UNDER DIV. C3.2.5.1 OF THE BUILDING CODE

As Built Concrete

NO	REVISION / ISSUE	DATE

SITE PLAN

CITY : BRAMPTON

21 BRAMFIELD STREET

EXISTING DWELLING

PROJECT

SHEET

SCALE 3/32"=1'-0"

**A1**