

Application for Minor VarianceSection 45 of the *Planning Act*, R.S.O. 1990 c.P.13**Please Note:** You are receiving this notice as you are within 60 meters of the subject property.

Application Number: A-2024-0459
Property Address: 32 Willick Place
Legal Description: Plan M1409, Lot 113, Ward5
Agent: Valiuddin Mohammed
Owner(s): Amarjeet Singh, Darshan Didar Kaur
Other applications: nil
under the *Planning Act*

Meeting Date and Time: Tuesday, February 25, 2025, at 9:30 am
Meeting Location: Hybrid in-person and virtual meeting – Council Chambers,
4th Floor Brampton City Hall, 2 Wellington Street West

Purpose of the Application:

1. To permit an interior side yard setback of 0.56 metres to an existing exterior stairway leading to a below grade entrance, whereas the by-law requires a minimum interior side yard setback of 1.2 metres on one side, and 0.6 metres on the other side; and
2. To permit an existing exterior stairway leading to a below grade entrance in a required side yard, whereas the by-law does not permit exterior stairways constructed below established grade in the required interior side yard.

Participate in the Meeting:

- Send an email with your written comments to coa@brampton.ca. Written submissions must include your name and mailing address, the application number or property address you are commenting on, along with authorization to post your correspondence on the agenda and must be received no later than **12:00 pm on Thursday, February 20, 2025**.
- Participate in person by attending the meeting on the date and time noted above. You are encouraged to register for in person attendance by emailing coa@brampton.ca and indicating if you plan to address Committee.
- Participate virtually (computer, tablet or smartphone). To participate virtually via WebEx, you must register in advance, no later than **12:00 pm on Thursday, February 20, 2025**, by emailing coa@brampton.ca, and providing your name, mailing address, phone number and email address. Confirmation of registration and participation instructions will be provided.

Note: Information provided in your correspondence, virtual or in-person delegation will become part of the public meeting record and will be posted on the City's website. If you do not participate in the public meeting, Committee may make a decision in your absence, and you will not be entitled to any further notice in the proceedings.


Viewing Application Materials: The application and related materials are available online at www.brampton.ca/en/city-hall/meetings-agendas and may be viewed in person in the City Clerk's Office during regular business hours. More information regarding the Committee of Adjustment is available at www.brampton.ca.

Appeal Process: If you wish to be notified of the decision of Committee, you must submit a written request to coa@brampton.ca. This will also entitle you to be advised of an appeal of the matter to the Ontario Land Tribunal (OLT). Please be advised that only the applicant, municipality, certain public bodies and the Minister can appeal a decision to the OLT. If a decision is appealed, you may request participant status by contacting olt.clo@ontario.ca.

Owners are requested to ensure that their tenant(s) are notified of this application and meeting date. This notice is to be posted by the owner of any land that contains seven or more residential units in a location that is visible to all of the residents.

Dated this 10th day of February 2025

Secretary Treasurer
Committee of Adjustment, City Clerk's Office
2 Wellington Street West, Brampton, L6Y 4R2
E: coa@brampton.ca

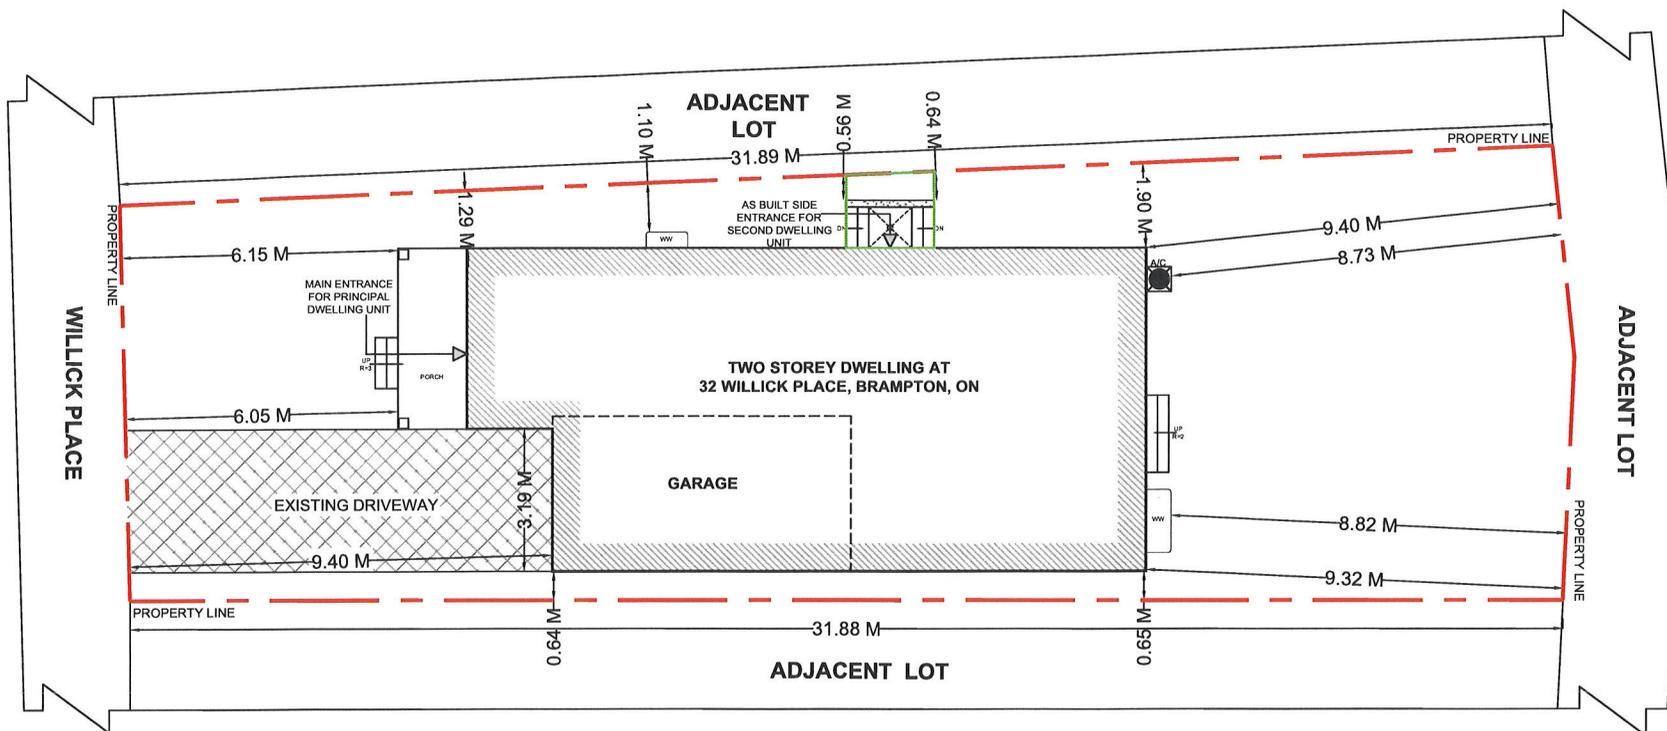


AREA STATISTICS:

GROSS FLOOR AREA CALCULATIONS	
A. PRINCIPAL RESIDENCE	
MAIN FLOOR G.F.A	= 864.50 ft ² / 80.31 m ²
SECOND FLOOR G.F.A	= 1105.97 ft ² / 102.74 m ²
TOTAL G.F.A	= 1970.47 ft ² / 183.06 m ²
B.	
BASEMENT G.F.A	= 864.50 ft ² / 80.31 m ²
BASEMENT APARTMENT G.F.A	= 864.50 ft ² / 80.31 m ²
▲	ENTRANCE / EGRESS

SCOPE OF WORK

- A. LEGALIZATION OF AS BUILT BASEMENT TO BASEMENT APARTMENT
- B. ENLARGEMENT OF TWO EXISTING WINDOWS
- C. LEGALIZATION OF AS BUILT BELOW GRADE ENTRANCE

GENERAL NOTES:
 DRAWINGS ARE TO BE READ NOT SCALED.
 CONTRACTOR MUST VERIFY ALL DIMENSIONS AND BE RESPONSIBLE FOR THE SAME.
 REPORT ANY DISCREPANCIES TO THE DESIGNER BEFORE COMMENCING THE WORK. THE DRAWINGS AND DOCUMENTS PROVIDED HERE WITHIN ARE THE EXCLUSIVE PROPERTY OF MECHWAYS INC. REPRODUCTION OF THE DOCUMENTS PROVIDED IS PROHIBITED WITHOUT THE CONSENT OF THE DESIGNER.
 ALL DESIGN AND CONSTRUCTION DOCUMENTATION ARE FINAL UNLESS REVISED BY THE DESIGNER. IF ANY DISCREPANCIES ARE DISCOVERED HERE WITHIN, THE DESIGNER SHALL BE NOTIFIED.

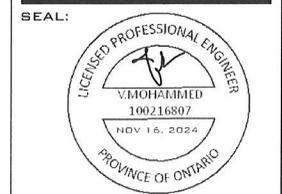

NO.	DESCRIPTION	DATE
2	REVISION - 1	DEC 09, 2024
1	ISSUED FOR BUILDING PERMIT	NOV 16, 2024

ENGINEER:
Mechways Inc.
 ADDRESS : 6 RIFON STREET MISSISSAUGA, ON. L4T 1E2
 TEL. : 416-627-4100
 EMAIL : INFO@MECHWAYS.COM
 WEBSITE : WWW.MECHWAYS.COM

CONSULTANT:

PROJECT:
 BASEMENT APARTMENT AT 32 WILLICK, BRAMPTON, ON

SHEET TITLE:
SITE PLAN

CHECKED: GS
 DRAWN: GS
 SCALE: 1 : 125
 DATE: NOV 16, 2024

