

APPLICATION FOR MINOR VARIANCE

WHEREAS an application for minor variance has been made by **AMANDEEP SINGH GILL AND HARPREET KAUR GILL** under Section 45 of the Planning Act, (R.S.O. 1990 c.P.13) for relief from **By-law 270-2004**;

AND WHEREAS the property involved in this application is described as Lot 39, Plan M-763 municipally known as **56 JAY STREET**, Brampton;

AND WHEREAS the applicants are requesting the following variance(s):

1. To permit the total width of both side yards on the lot to be 1.13m (3.71 ft.) whereas the by-law requires the total width of both side yards on the lot to be a minimum of 1.8m (5.91 ft.);
2. To permit a door on the side wall of a dwelling where the distance between the walls of the two dwellings is 2.34m (7.68 ft.) whereas the by-law does not permit a door on the side wall where the distance between the walls of two dwellings is less than 2.4m (7.88 ft.);
3. To permit a below grade entrance within a required interior side yard whereas the by-law does not permit a below grade entrance within a required interior side yard;
4. To permit a 1.11m (3.64 ft.) path of travel leading to a principle entrance for a second unit whereas the by-law requires a minimum unencumbered side yard width of 1.2m (3.94 ft.) be provided as a path of travel from the front yard to the entrance for a second unit.

The land which is subject of this application is the subject of an application under the Planning Act for:

Plan of Subdivision: _____ NO File Number: _____
Application for Consent: _____ NO File Number: _____

The Committee of Adjustment has appointed **TUESDAY, July 12, 2022 at 9:00 A.M. by electronic meeting broadcast from the Council Chambers, 4th Floor, City Hall, 2 Wellington Street West, Brampton**, for the purpose of hearing all parties interested in supporting or opposing these applications.

This notice is sent to you because you are either the applicant, a representative/agent of the applicant, a person having an interest in the property or an owner of a neighbouring property. **OWNERS ARE REQUESTED TO ENSURE THAT THEIR TENANTS ARE NOTIFIED OF THIS APPLICATION. THIS NOTICE IS TO BE POSTED BY THE OWNER OF ANY LAND THAT CONTAINS SEVEN OR MORE RESIDENTIAL UNITS IN A LOCATION THAT IS VISIBLE TO ALL OF THE RESIDENTS.** If you are not the applicant and you do not participate in the hearing, the Committee may proceed in your absence, and you will not be entitled to any further notice in the proceedings. **WRITTEN SUBMISSIONS MAY BE SENT TO THE SECRETARY-TREASURER AT THE ADDRESS OR FAX NUMBER LISTED BELOW.**

IF YOU WISH TO BE NOTIFIED OF THE DECISION OF THE COMMITTEE OF ADJUSTMENT IN RESPECT OF THIS APPLICATION, YOU MUST SUBMIT A WRITTEN REQUEST TO THE COMMITTEE OF ADJUSTMENT. This will also entitle you to be advised of an Ontario Land Tribunal hearing. Even if you are the successful party, you should request a copy of the decision since the Committee of Adjustment decision may be appealed to the Ontario Land Tribunal by the applicant or another member of the public.

RULES OF PROCEDURE OF THIS COMMITTEE REQUIRE REPRESENTATION OF THE APPLICATION AT THE HEARING, OTHERWISE THE APPLICATION SHALL BE DEFERRED.


PLEASE SEE ATTACHED PARTICIPATION PROCEDURES REQUIRED DURING THE COVID-19 PANDEMIC

DATED at Brampton Ontario, this 29th Day of June, 2022

Comments may be sent to and more information about this matter may be obtained between 8:30 a.m. to 4:30 p.m. Monday - Friday from:

Jeanie Myers, Secretary-Treasurer
Committee of Adjustment, City Clerk's Office,
Brampton City Hall, 2 Wellington Street West,
Brampton, Ontario L6Y 4R2
Phone: (905)874-2117
Fax: (905)874-2119
jeanie.myers@brampton.ca

56 JAY STREET, BRAMPTON

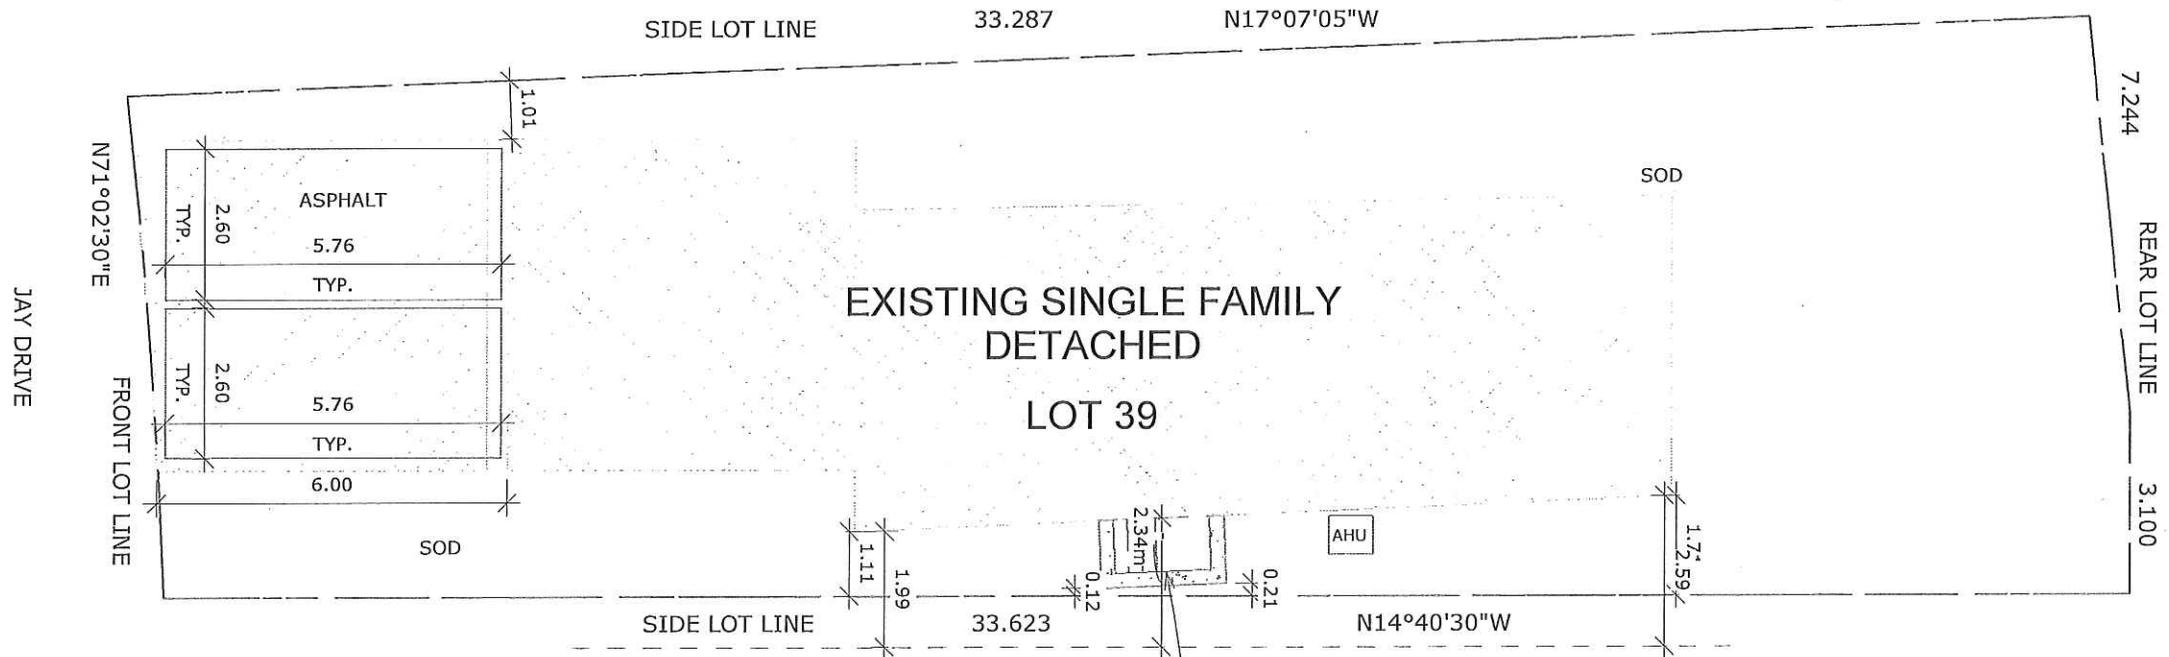

MINOR VARIANCE

SIDE YARD SETBACK TO BELOW GRADE STAIRS - 0.12m
 UNSTRUCTURED PATH TO THE PRINCIAL SECOND UNIT
 ENTRANCE - 1.11m

AS-BUILT
 BELOW GRADE
 STAIRS

The undersigned has reviewed and takes responsibility for this design, and has the qualifications and meets the requirements set out in the Ontario Building Code to be a Designer.		PROJECT	BELOW GRADE STAIRS
QUALIFICATION INFORMATION Required unless design is exempt under 3.2.5.1 of the building code		ADDRESS	56 JAY STREET, BRAMPTON
 BCIN: 101904	JAURA DESIGN STUDIO BCIN: 108652	DWG TITLE	SITE PLAN
		SCALE	1/8" = 1'-0"
REGISTRATION INFORMATION Required unless design is exempt under 3.2.5.1 of the building code		PROJECT NO	22036
		DRAWING NO	A101

Under the authority of the *Emergency Management and Civil Protection Act* and the *Municipal Act, 2001*, City Council approved Committee Meetings to be held electronically and/or as a hybrid meeting (both in-person and electronically).

**Electronic/Hybrid Hearing Procedures
How to get involved in the Hybrid Hearing**

As the pandemic has waned, Brampton City Hall is currently lifting in-person attendance restrictions due to the COVID pandemic. In-person attendance at Committee of Adjustment Hearings is now available at this time, along with a virtual participation option. Brampton City Council and its Committees will continue to meet electronically and in-person. For the **July 12, 2022** hearing, the Committee of Adjustment will conduct its meeting with concurrent electronic and in-person attendance.

How to Participate in the Hearing:

- All written comments (by mail or email) must be received by the Secretary-Treasurer no later than **4:30 pm, Thursday, July 7, 2022.**
- Advance registration for applicants, agents and other interested persons is required by one or two options:
 1. Participate remotely in the electronic hearing using a computer, smartphone or tablet by emailing the Secretary-Treasurer at cityclerksoffice@brampton.ca or jeanie.myers@brampton.ca by **4:30 pm Thursday, July 7, 2022.**
 2. To participate in-person, please email the Secretary-Treasurer at cityclerksoffice@brampton.ca or jeanie.myers@brampton.ca by **4:30 pm Thursday, July 7, 2022.**
- Persons without access to a computer, smartphone or tablet can participate in a meeting via telephone or in-person. You can register by calling 905-874-2117 and leave a message with your name, phone number and the application you wish to speak to by **Thursday, July 7, 2022.** City staff will contact you and provide you with further details.

You will be contacted by the City Clerk's Office before the hearing date to confirm your attendance. Confirmation of in-person attendance will be subject to any in-person capacity limits that may be in place for Council Chambers at City Hall and prevailing public health orders and guidance.

- All Hearings will be livestreamed on the City of Brampton YouTube account at:
<https://www.brampton.ca/EN/City-Hall/meetings-agendas/Pages/Welcome.aspx> or
<http://video.isilive.ca/brampton/live.html> .

If holding an electronic/hybrid rather than an oral hearing is likely to cause a party significant prejudice a written request may be made to have the Committee consider holding an oral hearing on an application at some future date. The request must include your name, address, contact information, and the reasons for prejudice and must be received no later than 4:30 pm the Friday prior to the hearing to cityclerksoffice@brampton.ca or jeanie.myers@brampton.ca. If a party does not submit a request and does not participate in the hearing, the Committee may proceed without a party's participation and the party will not be entitled to any further notice regarding the proceeding.

NOTE Personal information as defined in the *Municipal Freedom of Information and Protection of Privacy Act (MFIPPA)*, collected and recorded or submitted in writing or electronically as related to this planning application is collected under the authority of the *Planning Act*, and will be used by members of the Committee and City of Brampton staff in their review of this matter. Please be advised that your submissions will be part of the public record and will be made available to the public, including posting on the City's website, www.brampton.ca. By providing your information, you acknowledge that all personal information such as the telephone numbers, email addresses and signatures of individuals will be redacted by the Secretary-Treasurer on the on-line posting only. Questions regarding the collection, use and disclosure of personal information may be directed to the Secretary-Treasurer at 905-874-2117.

The City of Brampton is reviewing its Committee of Adjustment process. As a participant in this process, if you have comments or input you would like to share about your experience with the Committee of Adjustment, please email cityclerksoffice@brampton.ca to indicate your interest and you will be contacted with more information.

AMENDMENT LETTER

June 28, 2022

To: Committee of Adjustment

**RE: APPLICATION FOR MINOR VARIANCE
AMANDEEP SINGH GILL AND HARPREET KAUR GILL
LOT 39, PLAN M-763
A-2022-0187 – 56 JAY STREET**

Please **amend** application **A-2022-0187** to reflect the following:

1. To permit the total width of both side yards on the lot to be 1.13m (3.71 ft.) whereas the by-law requires the total width of both side yards on the lot to be a minimum of 1.8m (5.91 ft.);
2. To permit a door on the side wall of a dwelling where the distance between the walls of the two dwellings is 2.34m (7.68 ft.) whereas the by-law does not permit a door on the side wall where the distance between the walls of two dwellings is less than 2.4m (7.88 ft.);
3. To permit a below grade entrance within a required interior side yard whereas the by-law does not permit a below grade entrance within a required interior side yard;
4. To permit a 1.11m (3.64 ft.) path of travel leading to a principle entrance for a second unit whereas the by-law requires a minimum unencumbered side yard width of 1.2m (3.94 ft.) be provided as a path of travel from the front yard to the entrance for a second unit.



Applicant/Authorized Agent



For Office Use Only
(to be inserted by the Secretary-Treasurer
after application is deemed complete)

FILE NUMBER: A-2022-0187

The Personal Information collected on this form is collected pursuant to section 45 of the Planning Act and will be used in the processing of this application. Applicants are advised that the Committee of Adjustment is a public process and the information contained in the Committee of Adjustment files is considered public information and is available to anyone upon request and will be published on the City's website. Questions about the collection of personal information should be directed to the Secretary-Treasurer, Committee of Adjustment, City of Brampton.

APPLICATION

Minor Variance or Special Permission

(Please read Instructions)

NOTE: It is required that this application be filed with the Secretary-Treasurer of the Committee of Adjustment and be accompanied by the applicable fee.

The undersigned hereby applies to the Committee of Adjustment for the City of Brampton under section 45 of the Planning Act, 1990, for relief as described in this application from By-Law **270-2004**.

1. **Name of Owner(s)** AMANDEEP SINGH GILL & HARPREET KAUR GILL
Address 56 JAY STREET, BRAMPTON, ON, L6Z 3V5

Phone # 647-409-8701 **Fax #** _____
Email udaygill2009@gmail.com

2. **Name of Agent** KAMAL JAURA
Address 34 LENNON TRAIL, BRAMPTON, ON, L6Y 5P9

Phone # 647-853-4007 **Fax #** _____
Email info@jauradesign.ca

3. **Nature and extent of relief applied for (variances requested):**

- TO PERMIT AN INTERIOR SIDE YARD SETBACK OF 0.12m TO AN AS BUILT BELOW GRADE ENTRANCE STAIRS.
- TO PERMIT BELOW GRADE ENTRANCE STAIRS IN THE SIDE YARD

4. **Why is it not possible to comply with the provisions of the by-law?**

IRREGULAR LOT SIZE

5. **Legal Description of the subject land:** PLAN M763 LOT 39
Lot Number 39
Plan Number/Concession Number _____
Municipal Address 56 JAY STREET, BRAMPTON, ON, L6Z 3V5

6. **Dimension of subject land (in metric units)**
Frontage 8.88m
Depth 33.6m
Area 313.18 m2

7. **Access to the subject land is by:**

Provincial Highway <input type="checkbox"/>	Seasonal Road <input type="checkbox"/>
Municipal Road Maintained All Year <input checked="" type="checkbox"/>	Other Public Road <input type="checkbox"/>
Private Right-of-Way <input type="checkbox"/>	Water <input type="checkbox"/>

8. Particulars of all buildings and structures on or proposed for the subject land: (specify in metric units ground floor area, gross floor area, number of storeys, width, length, height, etc., where possible)

EXISTING BUILDINGS/STRUCTURES on the subject land: List all structures (dwelling, shed, gazebo, etc.)

GROSS FLOOR AREA - 186.2 m2 TWO STOREY HOUSE

PROPOSED BUILDINGS/STRUCTURES on the subject land:

AS-BUILT STAIRS IN THE SIDE YARD

9. Location of all buildings and structures on or proposed for the subject lands: (specify distance from side, rear and front lot lines in metric units)

EXISTING

Front yard setback	6.00
Rear yard setback	EXISTING TO REMAIN
Side yard setback	1.01
Side yard setback	1.11

PROPOSED

Front yard setback	6.00
Rear yard setback	EXISTING TO REMAIN
Side yard setback	1.01
Side yard setback	0.12

10. Date of Acquisition of subject land: MARCH 27, 2014

11. Existing uses of subject property: SINGLE FAMILY HOUSE

12. Proposed uses of subject property: TWO DWELLING UNIT

13. Existing uses of abutting properties: SINGLE FAMILY HOUSE

14. Date of construction of all buildings & structures on subject land: 1994

15. Length of time the existing uses of the subject property have been continued: 28

16. (a) What water supply is existing/proposed?
 Municipal Other (specify) _____
 Well

(b) What sewage disposal is/will be provided?
 Municipal Other (specify) _____
 Septic

(c) What storm drainage system is existing/proposed?
 Sewers Other (specify) _____
 Ditches
 Swales

17. Is the subject property the subject of an application under the Planning Act, for approval of a plan of subdivision or consent?

Yes No

If answer is yes, provide details: File # _____ Status _____

18. Has a pre-consultation application been filed?

Yes No

19. Has the subject property ever been the subject of an application for minor variance?

Yes No Unknown

If answer is yes, provide details:

File # _____	Decision _____	Relief _____
File # _____	Decision _____	Relief _____
File # _____	Decision _____	Relief _____

Signature of Applicant(s) or Authorized Agent

DATED AT THE _____ CITY _____ OF _____ BRAMPTON _____

THIS 27TH DAY OF MAY, 20 22.

IF THIS APPLICATION IS SIGNED BY AN AGENT, SOLICITOR OR ANY PERSON OTHER THAN THE OWNER OF THE SUBJECT LANDS, WRITTEN AUTHORIZATION OF THE OWNER MUST ACCOMPANY THE APPLICATION. IF THE APPLICANT IS A CORPORATION, THE APPLICATION SHALL BE SIGNED BY AN OFFICER OF THE CORPORATION AND THE CORPORATION'S SEAL SHALL BE AFFIXED.

I, AMANDEEP GILL, OF THE CITY OF BRAMPTON

IN THE REGION OF PEEL SOLEMNLY DECLARE THAT:

ALL OF THE ABOVE STATEMENTS ARE TRUE AND I MAKE THIS SOLEMN DECLARATION CONSCIENTIOUSLY BELIEVING IT TO BE TRUE AND KNOWING THAT IT IS OF THE SAME FORCE AND EFFECT AS IF MADE UNDER OATH.

DECLARED BEFORE ME AT THE

City OF Brampton

IN THE Region OF _____

Peel THIS 2nd DAY OF _____

June, 20 22.

A Commissioner etc.

Jeanie Cecilia Myers
a Commissioner, etc.,
Province of Ontario
for the Corporation of the
City of Brampton
Expires April 8, 2024.

Signature of Applicant or Authorized Agent

Submit by Email

FOR OFFICE USE ONLY

Present Official Plan Designation: _____

Present Zoning By-law Classification: R2A(2)-313

This application has been reviewed with respect to the variances required and the results of the said review are outlined on the attached checklist.


Zoning Officer

June 14, 2022
Date

DATE RECEIVED June 2, 2022

Date Application Deemed Complete by the Municipality June 14, 2022

56 JAY STREET, BRAMPTON

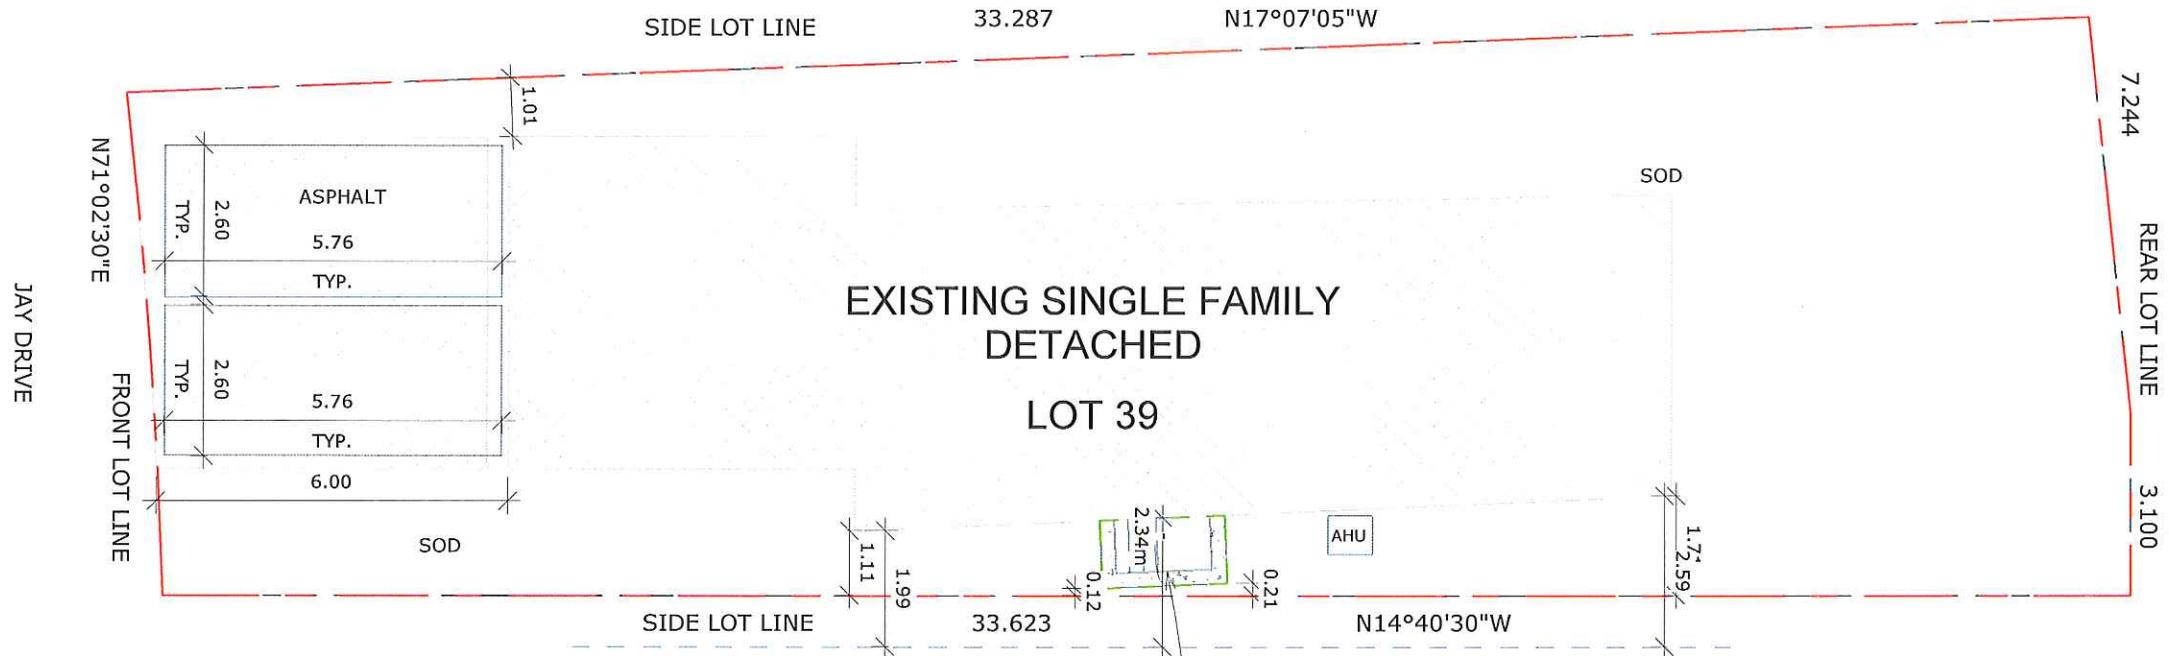


MINOR VARIANCE

SIDE YARD SETBACK TO BELOW GRADE STAIRS - 0.12m
 UNBSTRUCTED PATH TO THE PRINCIAL SECOND UNIT
 ENTRANCE - 1.11m

AS-BUILT
 BELOW GRADE
 STAIRS

The undersigned has reviewed and takes responsibility for this design, and has the qualifications and meets the requirements set out in the Ontario Building Code to be a Designer.		PROJECT	BELOW GRADE STAIRS
QUALIFICATION INFORMATION Required unless design is exempt under 3.2.5.1 of the building code		ADDRESS	56 JAY STREET, BRAMPTON
 BCIN: 101904	JAURA DESIGN STUDIO BCIN: 108652	DWG TITLE	SITE PLAN
		SCALE	1/8" = 1'-0"
REGISTRATION INFORMATION Required unless design is exempt under 3.2.5.1 of the building code		PROJECT NO	22036
		DRAWING NO	A101

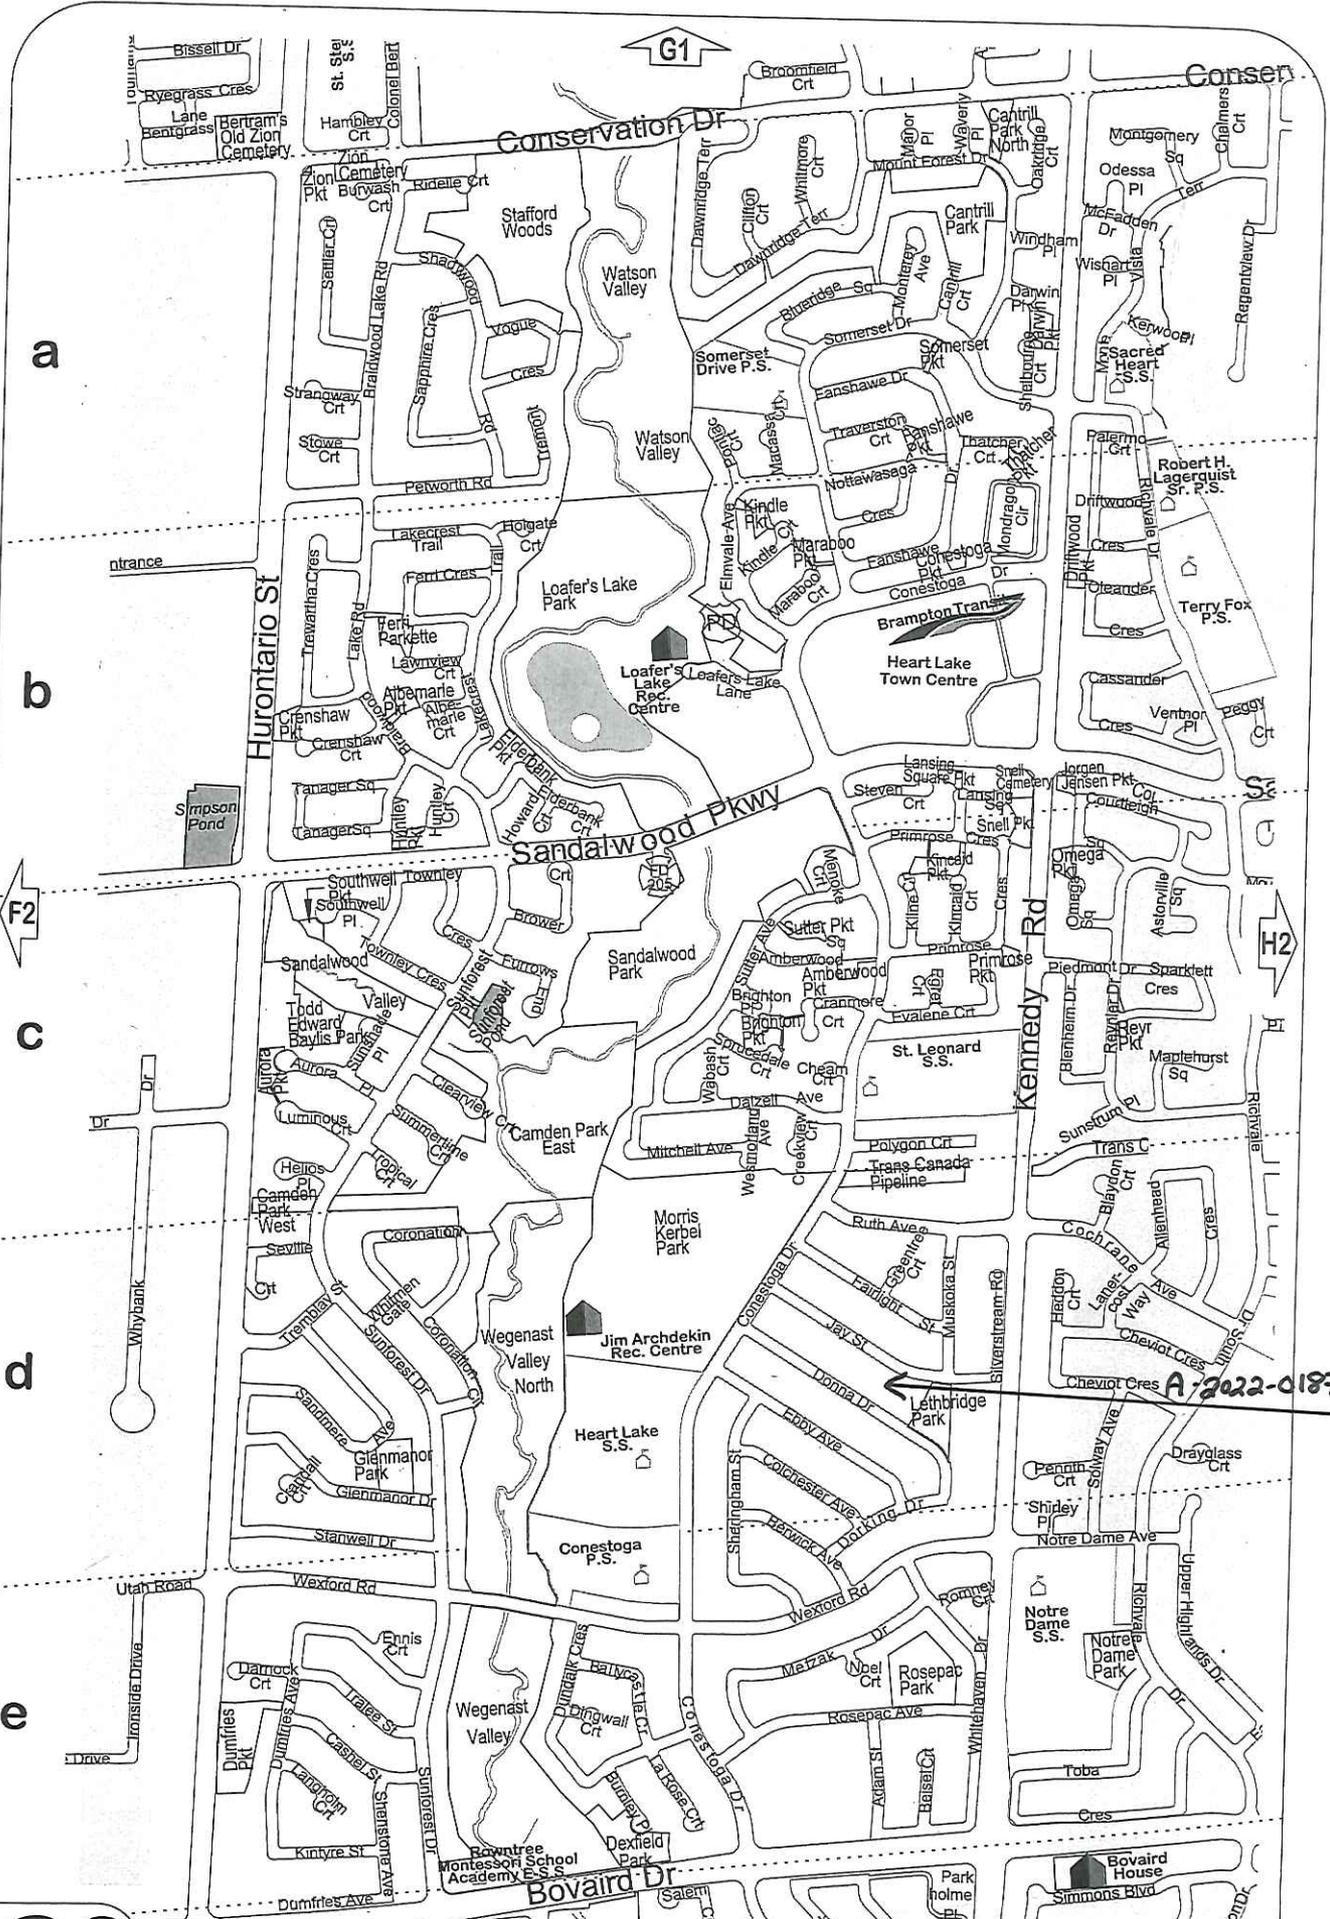

a

b

c

d

e

G1

F2

H2

A/2022-0187