

## **Public Notice**

### **Committee of Adjustment**

APPLICATION # A-2022-0238 WARD #9

#### APPLICATION FOR MINOR VARIANCE

WHEREAS an application for minor variance has been made by **NEAMSBY INVESTMENTS INC**. under Section 45 of the <u>Planning Act</u>, (R.S.O. 1990 c.P.13) for relief from **By-law 270-2004**;

AND WHEREAS the property involved in this application is described as Lot 198, Plan 43M-2103 located at the corner of streets municipally known as **GOODVIEW DRIVE AND INSPIRE BOULEVARD**, Brampton;

AND WHEREAS the applicant is requesting the following variance(s):

1. To permit an above grade door in the side wall where a minimum side yard width of 0.6m is provided extending from the front wall of the dwelling up to the door, whereas the by-law does not permit a door in the side wall unless there is a minimum side yard width of 1.2m extending from the front wall of the dwelling up to and including the door.

The land which is subject of this application is the subject of an application under the Planning Act for:

Plan of Subdivision:	NO	File Number: 21T-11006B
Application for Consent:	NO	File Number:
	y 8 92	

The Committee of Adjustment has appointed TUESDAY, August 23, 2022 at 9:00 A.M. by electronic meeting broadcast from the Council Chambers, 4th Floor, City Hall, 2 Wellington Street West, Brampton, for the purpose of hearing all parties interested in supporting or opposing these applications.

This notice is sent to you because you are either the applicant, a representative/agent of the applicant, a person having an interest in the property or an owner of a neighbouring property. OWNERS ARE REQUESTED TO ENSURE THAT THEIR TENANTS ARE NOTIFIED OF THIS APPLICATION. THIS NOTICE IS TO BE POSTED BY THE OWNER OF ANY LAND THAT CONTAINS SEVEN OR MORE RESIDENTIAL UNITS IN A LOCATION THAT IS VISIBLE TO ALL OF THE RESIDENTS. If you are not the applicant and you do not participate in the hearing, the Committee may proceed in your absence, and you will not be entitled to any further notice in the proceedings. WRITTEN SUBMISSIONS MAY BE SENT TO THE SECRETARY-TREASURER AT THE ADDRESS OR FAX NUMBER LISTED BELOW.

IF YOU WISH TO BE NOTIFIED OF THE DECISION OF THE COMMITTEE OF ADJUSTMENT IN RESPECT OF THIS APPLICATION, YOU MUST SUBMIT A WRITTEN REQUEST TO THE COMMITTEE OF ADJUSTMENT. This will also entitle you to be advised of an Ontario Land Tribunal hearing. Even if you are the successful party, you should request a copy of the decision since the Committee of Adjustment decision may be appealed to the Ontario Land Tribunal by the applicant or another member of the public.

RULES OF PROCEDURE OF THIS COMMITTEE REQUIRE REPRESENTATION OF THE APPLICATION AT THE HEARING, OTHERWISE THE APPLICATION SHALL BE DEFERRED.


#### PLEASE SEE ATTACHED PARTICIPATION PROCEDURES REQUIRED DURING THE COVID-19 PANDEMIC

DATED at Brampton Ontario, this 11th Day of August, 2022

Comments may be sent to and more information about this matter may be obtained between 8:30 a.m. to 4:30 p.m. Monday - Friday from:

Jeanie Myers, Secretary-Treasurer Committee of Adjustment, City Clerk's Office, Brampton City Hall, 2 Wellington Street West, Brampton, Ontario L6Y 4R2

Phone: (905)874-2117 Fax: (905)874-2119 jeanie.myers@brampton.ca

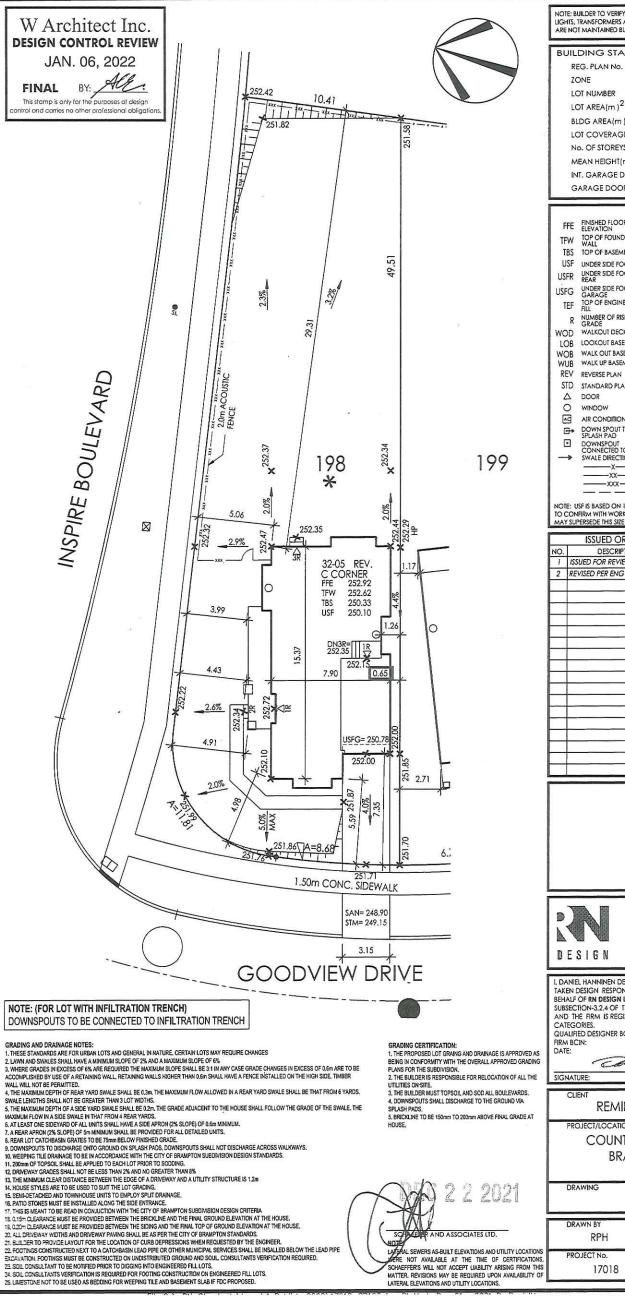

NOTE: BUILDER TO VERIFY LOCATION OF ALL HYDRANTS, STREET LIGHTS, TRANSFORMERS AND OTHER SERVICES, IF MIN. DIMENSIONS ARE NOT MAINTAINED BUILDER IS TO RELOCATE AT HIS OWN EXPENSE

BUILDING STATISTIC	S
REG. PLAN No.	43M-2103
ZONE	R1F-11.6-BBB3-38FT
LOT NUMBER	LOT 198
LOT AREA(m) <sup>2</sup>	640.48
BLDG AREA(m) <sup>2</sup>	
LOT COVERAGE(%)	
No. OF STOREYS	2
MEAN HEIGHT(m)	7.67
INT. GARAGE DIMS(m)	3.05x6.07
GARAGE DOOR(m)	2.44

	LEG	END	
FFE	FINISHED FLOOR ELEVATION	SP	SUMP PUMP
TFW	TOP OF FOUNDATION	$\boxtimes$	BELL PEDESTAL
	WALL		CABLE PEDESTAL
TBS	TOP OF BASEMENT SLAS	, П	CATCH BASIN
USF	UNDER SIDE FOOTING		DBL. CATCH BASIN
USFR	UNDER SIDE FOOTING @ REAR	*	ENGINEERED FILL
USFG	UNDER SIDE FOOTING @	44	HYDRO CONNECTION
TEF	TOP OF ENGINEERED	P	FIRE HYDRANT
	NUMBER OF RISERS TO	SL	STREET LIGHT
R	GRADE	$\bowtie$	MAIL BOX
WOD	WALKOUT DECK		TRANSFORMER
LOB	LOOKOUT BASEMENT	$\overline{\nabla}$	SEWER CONNECTIONS 2
WOB	WALK OUT BASEMENT	V	LOTS
WUB	WALK UP BASEMENT	V	SEWER CONNECTIONS 1
REV	REVERSE PLAN	÷	WATER CONNECTION
STD	STANDARD PLAN	0	WATER VALVE
Δ	DOOR	-	CHAMBER
0	WINDOW	Ŷ	HYDRANT AND VALVE
Ad	AIR CONDITIONING	Ħ	HYDRO METER
⊕	DOWN SPOUT TO	0	GAS METER
•	SPLASH PAD TUOQ2NWOO	$\circ$	MANHOLE - STORM
	CONNECTED TO STM	Ŏ	MANHOLE - SANITARY
$\rightarrow$	SWALE DIRECTION		
		CHAINLIN PRIVACY	IK FENCE
		SOUND B	
		FOOTING	TO BE EXTENDED
		10 1.22 (/	MIN) BELOW GRADE
NOIE: L	ISF IS BASED ON 150mm (		NG DEPTH, CONTRACTOR

NO.	DESCRIPTION	DATE	DWN	CHK
1	ISSUED FOR REVIEW	28-NOV-21	RPH	DJH
2	REVISED PER ENG COMM - FINAL	13-DEC-21	RPH	DJH
_				



WWW.RNDESIGN.COM T:905-738-3177 WWW.THEPLUSGROUP.CA

I. DANIEL HANNINEN DECLARE THAT I HAVE REVIEWED AND TAKEN DESIGN RESPONSIBILITY FOR THE DESIGN WORK ON BEHALF OF RN DESIGN LTD.UNDER DIVISION C.PART-3 SUBSECTION-3.2.4 OF THE BUILDING CODE. I AM QUALIFIED AND THE FIRM IS REGISTERED IN THE APPROPRIATE CLASSES / CATEGORIES.

CATEGORIES.

20888
FIRM BCIN:
26995
DATE:
21-DEC-21

**REMINGTON HOMES** 

COUNTRYSIDE VILLAGES BRAMPTON, ON

DRAWING

SITE PLAN

DRAWN BY	SCALE
RPH	1:250
PROJECT No.	LOT NUMBER
17018	LOT 198

2 2 2021

SOLYJEPAN SEWERS AS BUILT ELEVATIONS AND UTILITY LOCATIONS
JEPAN NOT AVAILABLE AT THE TIME OF CERTIFICATIONS.
SCHAEFERS WILL NOT ACCEPT LABILITY ARISING FROM THIS
MATTER. REVISIONS MAY BE REQUIRED UPON AVAILABILITY OF
LATERAL ELEVATIONS AND UTILITY LOCATIONS.



Under the authority of the Emergency *Management and Civil Protection Act* and the *Municipal Act, 2001*, City Council approved Committee Meetings to be held electronically and/or as a hybrid meeting (both inperson and electronically).

#### Electronic/Hybrid Hearing Procedures How to get involved in the Hybrid Hearing

As the pandemic has waned, Brampton City Hall is currently lifting in-person attendance restrictions due to the COVID pandemic. In-person attendance at Committee of Adjustment Hearings is now available at this time, along with a virtual participation option. Brampton City Council and its Committees will continue to meet electronically and in-person. For the **August 23**, **2022** hearing, the Committee of Adjustment will conduct its meeting with concurrent electronic and in-person attendance.

#### How to Participate in the Hearing:

All written comments (by mail or email) must be received by the Secretary-Treasurer no later than 4:30 pm, Thursday, August 18, 2022.

- Advance registration for applicants, agents and other interested persons is required by one or two options:
  - 1. Participate remotely in the electronic hearing using a computer, smartphone or tablet by emailing the Secretary–Treasurer at <a href="mailto:cityclerksoffice@brampton.ca">cityclerksoffice@brampton.ca</a> or <a href="mailto:jeanie.myers@brampton.ca">jeanie.myers@brampton.ca</a> by 4:30 pm Thursday, August 18, 2022.
- 2. To participate in-person, please email the Secretary–Treasurer at <a href="mailto:cityclerksoffice@brampton.ca">cityclerksoffice@brampton.ca</a> or <a href="mailto:jeanie.myers@brampton.ca">jeanie.myers@brampton.ca</a> by 4:30 pm Thursday, August 18, 2022.
- Persons without access to a computer, smartphone or tablet can participate in a meeting via telephone or inperson. You can register by calling 905-874-2117 and leave a message with your name, phone number and
  the application you wish to speak to by Thursday, August 18, 2022. City staff will contact you and provide
  you with further details.

You will be contacted by the City Clerk's Office before the hearing date to confirm your attendance. Confirmation of in-person attendance will be subject to any in-person capacity limits that may be in place for Council Chambers at City Hall and prevailing public health orders and guidance.

 All Hearings will be livestreamed on the City of Brampton YouTube account at: https://www.brampton.ca/EN/City-Hall/meetings-agendas/Pages/Welcome.aspx or http://video.isilive.ca/brampton/live.html.

If holding an electronic/hybrid rather than an oral hearing is likely to cause a party significant prejudice a written request may be made to have the Committee consider holding an oral hearing on an application at some future date. The request must include your name, address, contact information, and the reasons for prejudice and must be received no later than 4:30 pm the Friday prior to the hearing to <a href="mailto:cityclerksoffice@brampton.ca">cityclerksoffice@brampton.ca</a> or <a href="mailto:jeanie.myers@brampton.ca">jeanie.myers@brampton.ca</a>. If a party does not submit a request and does not participate in the hearing, the Committee may proceed without a party's participation and the party will not be entitled to any further notice regarding the proceeding.

**NOTE** Personal information as defined in the *Municipal Freedom of Information and Protection of Privacy Act* (*MFIPPA*), collected and recorded or submitted in writing or electronically as related to this planning application is collected under the authority of the *Planning Act*, and will be used by members of the Committee and City of Brampton staff in their review of this matter. Please be advised that your submissions will be part of the public record and will be made available to the public, including posting on the City's website, www.brampton.ca. By providing your information, you acknowledge that all personal information such as the telephone numbers, email addresses and signatures of individuals will be redacted by the Secretary-Treasurer on the on-line posting only. Questions regarding the collection, use and disclosure of personal information may be directed to the Secretary-Treasurer at 905-874-2117.

The City of Brampton is reviewing its Committee of Adjustment process. As a participant in this process, if you have comments or input you would like to share about your experience with the Committee of Adjustment, please email <a href="mailto:cityclerksoffice@brampton.ca">cityclerksoffice@brampton.ca</a> to indicate your interest and you will be contacted with more information.

# Flower City



For Office Use Only (to be inserted by the Secretary-Treasurer after application is deemed complete)

FILE NUMBER: A - 2022-0238

The Personal Information collected on this form is collected pursuant to section 45 of the Planning Act and will be used in the processing of this application. Applicants are advised that the Committee of Adjustment is a public process and the information contained in the Committee of Adjustment files is considered public information and is available to anyone upon request and will be published on the City's website. Questions about the collection of personal information should be directed to the Secretary-Treasurer, Committee of Adjustment, City of Brampton.

## **APPLICATION** Minor Variance or Special Permission

(Please read Instructions)

It is required that this application be filed with the Secretary-Treasurer of the Committee of Adjustment and be NOTE: accompanied by the applicable fee.


		rsigned hereby applies to the ( ing Act, 1990, for relief as des			under section 45 of
1.	Name of	Owner(s) Neamsby Investme	nts Inc. c/o Remington Gro	oup Inc.	
	Address	1001 Necie Otreet, Ouite 100			
		Concord, ON L4K 1Y2			
	Phone #	attn: Jason Sheldon		F #	
	Email	jsheldon@remingtongroupinc.com		Fax #	
	Lilian	jerote negroningtong roupino.com		_	
2.	Name of	Agent KLM Planning Partr	ners Inc.		
	Address	64 Jardin Drive Unit 1B			
		Concord, ON L4K 3P3			
		attn: Keith MacKinnon / Laur	en Dynes	5001 - 20W	
	Phone #	905.669.4055 (ext. 234)		Fax #	
	Email	kmackinnon@klmplanning.com / ldyr	nes@kimpianning.com		
3.	Nature ar	nd extent of relief applied for	(variances requested	N•	
٥.			•	1	1 12 2 2 2 2 2
	10 perm	nit an above grade door in	the side wall where	e a minimum side yard	width of 0.6m is
	provided	extending from the front	wall of the dwelling	up to the door, where	as the by-law
		t permit a door in the side			width of 1.2m
	extendir	ng from the front wall of th	e dwelling up to an	d including the door.	
		s			
	18/1				
4.		not possible to comply with			9 18 60 NO 1000.5
	The Zon	ing By-law cannot be con	nplied with as the m	nodels of the single det	tached dwellings
	were de	signed, generally approve	ed, and sold under t	the provisions of the ol	d By-law. The
	location	of the side door is intention	onally leading into a	a mudroom attached to	the garage.
		e door is not intended for t			
	require t	the wider access to be use	ed as a primary dod	or to a secondary suite	•
5.	Legal Des	scription of the subject land:			
	Lot Numb				
		ber/Concession Number	43M-2103		
	Municipal	Address Goodview Drive/Inspire	e Boulevard		
6.	Dimensio	n of subject land ( <u>in metric u</u>	unita)		
<b>.</b>	Frontage		iiiis)		
	Depth	49.51m			
	Area	515m2			
<b>7</b> .	Access to	the subject land is by:			
		l Highway		Seasonal Road	
	79 <del>.7</del> 7	Road Maintained All Year	<b>✓</b>	Other Public Road	
	Private Ri	ght-of-Way		Water	

8.	Particulars of all buildings and structures on or proposed for the subject land: (specify in metric units ground floor area, gross floor area, number of storeys, width, length, height, etc., where possible)		
	EXISTING BUILDING	SS/STRUCTURES on the	ne subject land: List all structures (dwelling, shed, gazebo, etc.)
	Vacant residential		
	PROPOSED BUILDII	NGS/STRUCTURES on	the subject land:
	Two-storey single	detached residentia	al dwelling with a GFA of 2,287 sq.ft.
9.			ructures on or proposed for the subject lands: and front lot lines in metric units)
	EXISTING		
	Front yard setback Rear yard setback	N/A N/A	
	Side yard setback	N/A	
	Side yard setback	N/A	
	PROPOSED Front yard setback Rear yard setback Side yard setback Side yard setback	4.98m 29.31m 0.65m 4.91m	
10.	Date of Acquisition (	of subject land:	1998
11.	Existing uses of sub	ject property:	Vacant - Residential
12.	Proposed uses of su	bject property:	Residential
13.	Existing uses of abu	tting properties:	Vacant Residential
14.	Date of construction	of all buildings & stru	octures on subject land: N/A - Vacant
15.	Length of time the ex	xisting uses of the sub	pject property have been continued: 7 years
16. (a)	What water supply is Municipal ✓ Well	s existing/proposed?   	Other (specify)
(b)	What sewage dispos Municipal ✓ Septic	al is/will be provided?   	Other (specify)
(c)	What storm drainage Sewers  Ditches  Swales	e system is existing/pr     	oposed? Other (specify)

17.	subdivision or cons	rty the subject of a ent?	an application unde	r the Planning Act, for approval of a plan
	Yes 🗹	No		
	If answer is yes, pro	vide details: Fi	ile # 21T-11006B	Status Approved
18.	Has a pre-consultati	on application bee	n filed?	
	Yes	No 🗹		
19.	Has the subject prop	perty ever been the	subject of an appli	cation for minor variance?
	Yes	No [√]	Unknown	T
	If answer is yes, pro	SANSA MARKANIA	Olikliowit	
	File #			
	File#	Decision Decision		Relief Relief
	File #	Decision	2	Relief
				LAIMO
			Signatu	ure of Applicant(s) or Authorized Agent
DAT	ED AT THE City	OF		are or Applicant(s) or Admonzed. Agent
THIS	20 DAY OF	2 9	20 22	
THE APP	OLCI LANDO, WKILLE	ORATION. THE A	PPLICATION SHALL	NY PERSON OTHER THAN THE OWNER O MUST ACCOMPANY THE APPLICATION. I L BE SIGNED BY AN OFFICER OF THI D.
1	, Lauren Dynes		. OF THE	Town OF Aurora
IN THE	Region OF	York	SOLEMNLY DE	
OATH.	HE ABOVE STATEME G IT TO BE TRUE AND D BEFORE ME AT THE	RNOWING THAT	ND I MAKE THIS SO	DLEMN DECLARATION CONSCIENTIOUSLY E FORCE AND EFFECT AS IF MADE UNDER
City		- 1		
Oity	_ OF <u>Vaughan</u>			
IN THE	Region	. OF		
York	THIS 20	DAY OF		Zdyno
duly	20 22 Ruby Lyn Salas del Mande		Signat	ure of Applicant or Authorized Agent
Spans	a Commissioner, etc., Province of for KLM Planning Periners	Ontario,		g
The same of the sa	A Commissioner etc.	1		
		ij		
		FOR C	FFICE USE ONLY	
	Present Official Plan	Designation:		
	Present Zoning By-la	w Classification:		R1F-9 Section 2368
	This application has b	een reviewed with r said review are out	respect to the variand tlined on the attached	es required and the results of the dichecklist.
	Rose Bruno	)		July 24, 2022
	The Control of the Co	Officer		July 21, 2022 Date
	DATE	RECEIVED	Aulu 21.	2022

TE RECEIVED LIQ 21, 2022

Revised 2020/01/07

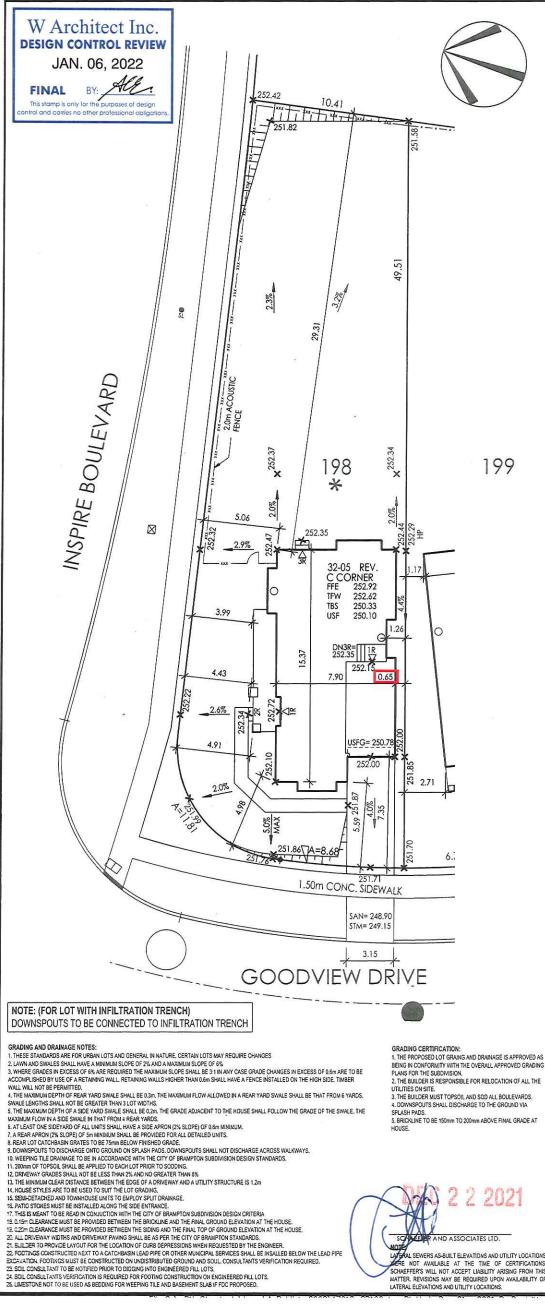

5. BRICKLINE TO BE 150mm TO 200mm ABOVE FINAL GRADE AT

OTI 23TAIDO22

LITTAL SEWERS AS-BUILT ELEVATIONS AND UTILITY LOCATIONS LETE NOT AVAILABLE AT THE TIME OF CERTIFICATIONS. SCHAEFFERS WILL NOT ACCEPT LIABILITY ARISING FROM THIS MATTER. REVISIONS MAY BE REQUIRED UPON AVAILABILITY OF LATERAL ELEVATIONS AND UTILITY LOCATIONS.

NOTE: BUILDER TO VERIFY LOCATION OF ALL HYDRANTS, STREET LIGHTS, TRANSFORMERS AND OTHER SERVICES. IF MIN. DIMENSIONS ARE NOT MAINTAINED BUILDER IS TO RELOCATE AT HIS OWN EXPENSE.

43M-2103 REG. PLAN No. ZONE R1F-11.6-BBB3-38FT LOT NUMBER LOT 198 LOT AREA(m)<sup>2</sup> 640.48 BLDG AREA(m)<sup>2</sup> LOT COVERAGE(%) No. OF STOREYS MEAN HEIGHT (m) 7.67 INT. GARAGE DIMS(m) 3.05x6.07 GARAGE DOOR(m) 2.44

M

BELL PEDESTAL

CATCH BASIN

CABLE PEDESTAL

DBL. CATCH BASIN

ENGINEERED FILL

FINISHED FLOOR ELEVATION TOP OF FOUNDATION WALL

TOP OF BASEMENT SLAB

UNDER SIDE FOOTING UNDER SIDE FOOTING @ REAR

FFF

TFW

TBS

USF

**USFR** 

UNDER SIDE FOOTING @ GARAGE TOP OF ENGINEERED FILL \* HYDRO CONNECTION USFG 4 FIRE HYDRANT TEF STREET LIGHT NUMBER OF RISERS TO GRADE R MAIL BOX WALKOUT DECK WOD  $\nabla$ TRANSFORMER SEWER CONNECTIONS 2 LOTS LOOKOUT BASEMENT WALK OUT BASEMENT WALK UP BASEMENT LOB WOB SEWER CONNECTIONS I 17 WUB REVERSE PLAN WATER CONNECTION STD STANDARD PLAN WATER VALVE CHAMBER 0 DOOR HYDRANT AND VALVE WINDOW AG AIR CONDITIONING HYDRO METER GAS METER MANHOLE - STORM DOWN SPOUT TO SPLASH PAD **□**• • DOWNSPOUT CONNECTED TO STM SWALE DIRECTION MANHOLE - SANITARY X CHAINLINK FENCE

XXX PRIVACY FENCE

XXX SOUND BARRIER

FOOTING TO BE EXTENDED

TO 1.22 (MIN) BELOW GRADE

NOTE: USF IS BASED ON 150mm (6) FOOTING DEPTH. CONTRACTOR

TO CONFIRM WITH WORKING DRAWINGS FOR SPECIFIC SIZES THAT

MAY SUPERSEDE THIS SIZE.

NO.	DESCRIPTION	DATE	DWN	CHK
1	ISSUED FOR REVIEW	28-NOV-21		
2	REVISED PER ENG COMM - FINAL	13-DEC-21	RPH	DJH



WWW.RNDESIGN.COM T:905-738-3177 WWW.THEPLUSGROUP.CA

I, DANIEL HANNINEN DECLARE THAT I HAVE REVIEWED AND
TAKEN DESIGN RESPONSIBILITY FOR THE DESIGN WORK ON
BEHALF OF RN DESIGN LTD, UNDER DIVISION C, PART-3
SUBSECTION-3.2.4 OF THE BUILDING CODE. I AM QUALIFIED
AND THE FIRM IS REGISTERED IN THE APPROPRIATE CLASSES /
CATEGORIES.
QUALIFIED DESIGNER 8CIN: 20888
FIRM BCIN: 26995
DATE: 21-DEC-21

SIGNATURE

REMINGTON HOMES

PROJECT/LOCATION

COUNTRYSIDE VILLAGES BRAMPTON, ON

SITE PLAN

DRAWN BY	SCALE
RPH	1:250
PROJECT No.	LOT NUMBER
17018	LOT 198

