

APPLICATION # A-2021-0229
WARD #5

APPLICATION FOR MINOR VARIANCE

WHEREAS an application for minor variance has been made by **VIVEK MEHTA AND ROMA MEHTA** under Section 45 of the Planning Act, (R.S.O. 1990 c.P.13) for relief from **By-law 270-2004**;

AND WHEREAS the property involved in this application is described as Part of Block 351, Plan 43M-1720, Parts 5 and 6, Plan 43R-31835 municipally known as **15 EVANWOOD CRESCENT**, Brampton;

AND WHEREAS the applicants are requesting the following variance(s):

1. To permit a proposed above grade door located on the side wall of the dwelling where the width of the yard extending from the rear wall of the dwelling is 0.56m (1.84 ft.) and where there is no yard having a continuous minimum width of 1.2m (3.94 ft.) extending from the front wall on either side of the dwelling to the proposed side door whereas the by-law requires a continuous minimum width of 1.2m (3.94 ft.) extending from the front wall along either side of the dwelling to an above grade door in the side wall;
2. To permit an existing driveway width of 5.35m (17.55 ft.) whereas the by-law permits a maximum driveway width of 4.9m (16.08 ft.).

OTHER PLANNING APPLICATIONS:

The land which is subject of this application is the subject of an application under the Planning Act for:

Plan of Subdivision: NO
Application for Consent: NO

File Number: _____
File Number: _____

The Committee of Adjustment has appointed **TUESDAY, October 26, 2021 at 9:00 A.M. by electronic meeting broadcast from the Council Chambers, 4th Floor, City Hall, 2 Wellington Street West, Brampton**, for the purpose of hearing all parties interested in supporting or opposing these applications.

This notice is sent to you because you are either the applicant, a representative/agent of the applicant, a person having an interest in the property or an owner of a neighbouring property. **OWNERS ARE REQUESTED TO ENSURE THAT THEIR TENANTS ARE NOTIFIED OF THIS APPLICATION. THIS NOTICE IS TO BE POSTED BY THE OWNER OF ANY LAND THAT CONTAINS SEVEN OR MORE RESIDENTIAL UNITS IN A LOCATION THAT IS VISIBLE TO ALL OF THE RESIDENTS.** If you are not the applicant and you do not participate in the hearing, the Committee may proceed in your absence, and you will not be entitled to any further notice in the proceedings. **WRITTEN SUBMISSIONS MAY BE SENT TO THE SECRETARY-TREASURER AT THE ADDRESS OR FAX NUMBER LISTED BELOW.**

IF YOU WISH TO BE NOTIFIED OF THE DECISION OF THE COMMITTEE OF ADJUSTMENT IN RESPECT OF THIS APPLICATION, YOU MUST SUBMIT A WRITTEN REQUEST TO THE COMMITTEE OF ADJUSTMENT. This will also entitle you to be advised of a Local Planning Appeal Tribunal hearing. Even if you are the successful party, you should request a copy of the decision since the Committee of Adjustment decision may be appealed to the Local Planning Appeal Tribunal by the applicant or another member of the public.

RULES OF PROCEDURE OF THIS COMMITTEE REQUIRE REPRESENTATION OF THE APPLICATION AT THE HEARING, OTHERWISE THE APPLICATION SHALL BE DEFERRED.

PLEASE SEE ATTACHED PARTICIPATION PROCEDURES REQUIRED DURING THE COVID-19 PANDEMIC



DATED at Brampton Ontario, this 14th Day of October, 2021.

Comments may be sent to and more information about this matter may be obtained between 8:30 a.m. to 4:30 p.m. Monday - Friday from:

Jeanie Myers, Secretary-Treasurer
Committee of Adjustment, City Clerk's Office,
Brampton City Hall, 2 Wellington Street West,
Brampton, Ontario L6Y 4R2
Phone: (905)874-2117
Fax: (905)874-2119
jeanie.myers@brampton.ca

LEGEND	
	GRASS
	EXISTING DRIVEWAY
	AS BUILT EXTENSION
	GRAVEL

MINOR VARIANCE APPLICATION
SIDE YARD ENTRANCE (PERSONAL USE) WITHOUT A UNOBSTRUCTED 1.2m PATH OF TRAVEL.
MAXIMUM DRIVEWAY WIDTH. PROPOSED 5.35m DRIVEWAY WIDTH.

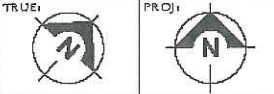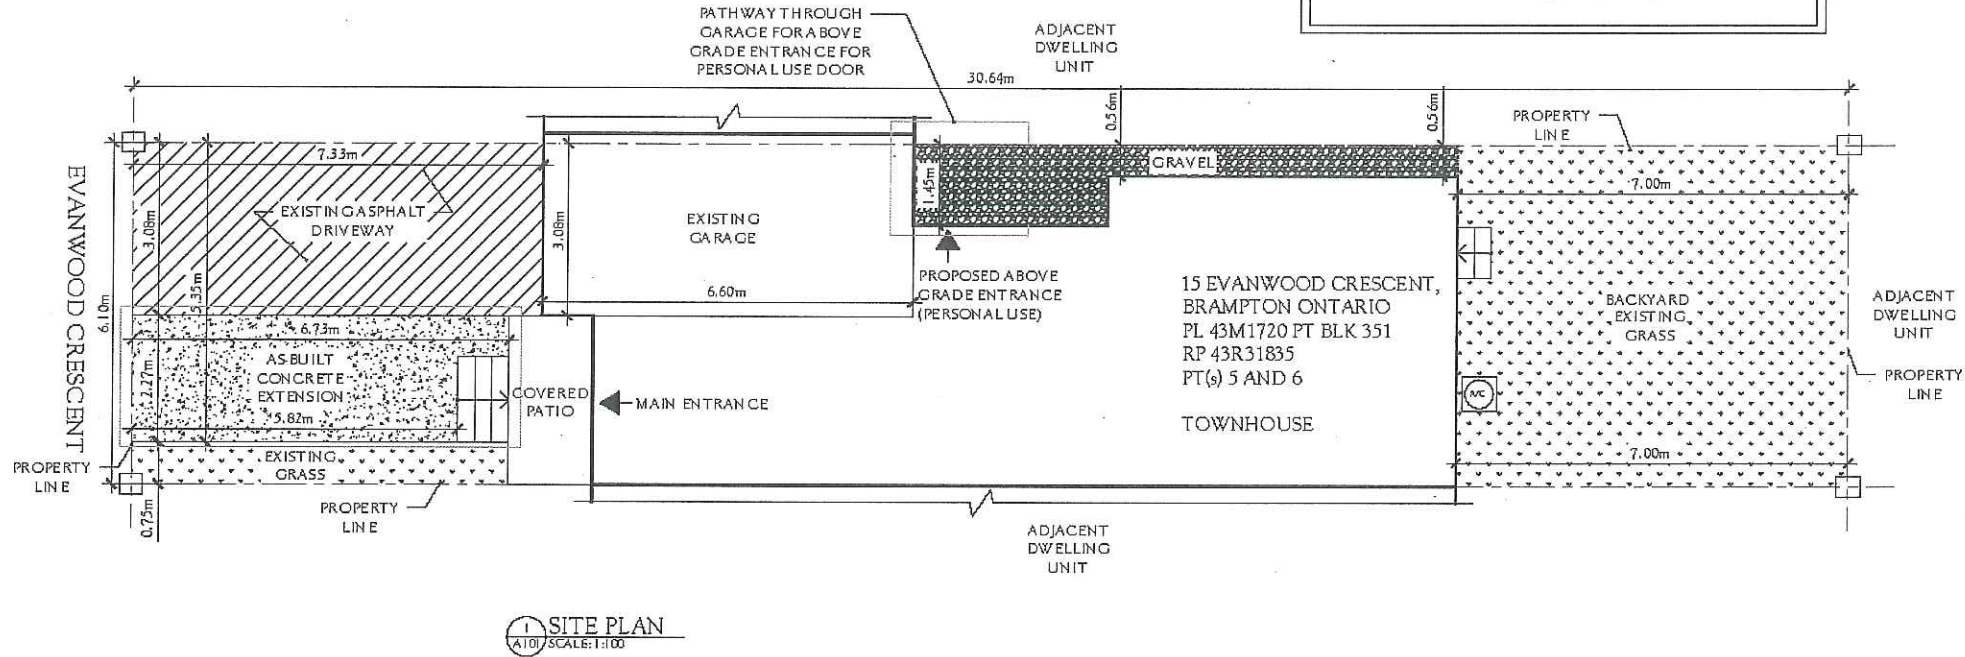

PROJECT TITLE: 15 EVANWOOD CRESCENT	
DRAWING TITLE: SITE PLAN	
SCALE: 1:100	DATE: 2021/09/23
DESIGNED BY: SINGH D. MARTINS R.	REVISION: 0
PROJECT NO. -	SHEET NO. A-101

Under the authority of the *Emergency Management and Civil Protection Act* and the *Municipal Act, 2001*, City Council approved Committee Meetings to be held electronically during the COVID-19 Emergency

**Electronic Hearing Procedures
How to get involved in the Virtual Hearing**

Brampton City Hall is temporarily closed to help stop the spread of COVID-19. In-person Committee of Adjustment Hearings have been cancelled since mid-March 2020. Brampton City Council and some of its Committees are now meeting electronically during the Emergency. The Committee of Adjustment will conduct its meeting electronically until further notice.

How to Participate in the Hearing:

- All written comments (by mail or email) must be received by the Secretary-Treasurer no later than **4:30 pm, Thursday, October 21, 2021**.
- Advance registration for applicants, agents and other interested persons is required to participate in the electronic hearing using a computer, smartphone or tablet by emailing the Secretary-Treasurer at cityclerksoffice@brampton.ca or jeanie.myers@brampton.ca by **4:30 pm Friday, October 22, 2021**.
 - Persons without access to a computer, smartphone or tablet can participate in a meeting via telephone. You can register by calling 905-874-2117 and leave a message with your name, phone number and the application you wish to speak to by **Friday, October 22, 2021**. City staff will contact you and provide you with further details.
- All Hearings will be livestreamed on the City of Brampton YouTube account at:
<https://www.brampton.ca/EN/City-Hall/meetings-agendas/Pages/Welcome.aspx> or
<http://video.isilive.ca/brampton/live.html>.

If holding an electronic rather than an oral hearing is likely to cause a party significant prejudice a written request may be made to have the Committee consider holding an oral hearing on an application at some future date. The request must include your name, address, contact information, and the reasons for prejudice and must be received no later than 4:30 pm the Friday prior to the hearing to cityclerksoffice@brampton.ca or jeanie.myers@brampton.ca. If a party does not submit a request and does not participate in the hearing, the Committee may proceed without a party's participation and the party will not be entitled to any further notice regarding the proceeding.

NOTE Personal information as defined in the *Municipal Freedom of Information and Protection of Privacy Act (MFIPPA)*, collected and recorded or submitted in writing or electronically as related to this planning application is collected under the authority of the *Planning Act*, and will be used by members of the Committee and City of Brampton staff in their review of this matter. Please be advised that your submissions will be part of the public record and will be made available to the public, including posting on the City's website, www.brampton.ca. By providing your information, you acknowledge that all personal information such as the telephone numbers, email addresses and signatures of individuals will be redacted by the Secretary-Treasurer on the on-line posting only. Questions regarding the collection, use and disclosure of personal information may be directed to the Secretary-Treasurer at 905-874-2117.

Flower City



brampton.ca

FILE NUMBER: A-2021-0229

The Personal Information collected on this form is collected pursuant to section 45 of the Planning Act and will be used in the processing of this application. Applicants are advised that the Committee of Adjustment is a public process and the information contained in the Committee of Adjustment files is considered public information and is available to anyone upon request and will be published on the City's website. Questions about the collection of personal information should be directed to the Secretary-Treasurer, Committee of Adjustment, City of Brampton.

APPLICATION

Minor Variance or Special Permission

(Please read Instructions)

NOTE: It is required that this application be filed with the Secretary-Treasurer of the Committee of Adjustment and be accompanied by the applicable fee.

The undersigned hereby applies to the Committee of Adjustment for the City of Brampton under section 45 of the Planning Act, 1990, for relief as described in this application from By-Law **270-2004**.

1. **Name of Owner(s)** Vivek Mehta & Roma Mehta
Address 15 Evanwood Crescent, Brampton Ontario L6X 0P8

Phone # 416-271-4459 **Fax #** _____
Email mehtviv@gmail.com
2. **Name of Agent** _____
Address _____

Phone # _____ **Fax #** _____
Email _____
3. **Nature and extent of relief applied for (variances requested):**
1. Proposed Above Grade Entrance (Personal Use) Without a 1.2m Path Of Travel. 0m Path Proposed.
2. Proposed 5.35m Driveway Width (4.9m Allowed By Zoning)

4. **Why is it not possible to comply with the provisions of the by-law?**
1. New Zoning By Law Amendment Requires 1.2m Path Of Travel To Above Grade Entrance.
2. Zoning Only Allows 4.9m Maximum Driveway Extension.

5. **Legal Description of the subject land**
Lot Number Part 5
Plan Number/Concession Number 43M-1720 PT BLK 351 RP 43R31835 Pt(s) 5 AND 6
Municipal Address 15 Evanwood Crescent, Brampton Ontario L6X 0P8
6. **Dimension of subject land (in metric units)**
Frontage 6.10m
Depth 30.64m
Area 186.89sqm.
7. **Access to the subject land is by:**

Provincial Highway	<input type="checkbox"/>	Seasonal Road	<input type="checkbox"/>
Municipal Road Maintained All Year	<input checked="" type="checkbox"/>	Other Public Road	<input type="checkbox"/>
Private Right-of-Way	<input type="checkbox"/>	Water	<input type="checkbox"/>

8. Particulars of all buildings and structures on or proposed for the subject land: (specify in metric units ground floor area, gross floor area, number of storeys, width, length, height, etc., where possible)

EXISTING BUILDINGS/STRUCTURES on the subject land: List all structures (dwelling, shed, gazebo, etc.)
Single Family Dwelling: Approx. 1800sqft (167.23sqm); 2 Story Building, Interior Townhouse Unit.

PROPOSED BUILDINGS/STRUCTURES on the subject land:
Single Family Dwelling (Existing), Proposed Above Grade Entrance To Single Family Dwelling.

9. Location of all buildings and structures on or proposed for the subject lands: (specify distance from side, rear and front lot lines in metric units)

EXISTING
Front yard setback 6.73m
Rear yard setback 7m
Side yard setback 1.45m
Side yard setback 0m

PROPOSED
Front yard setback 6.73m
Rear yard setback 7m
Side yard setback 1.45m
Side yard setback 0m

10. Date of Acquisition of subject land: 2020
11. Existing uses of subject property: Residential
12. Proposed uses of subject property: Residential
13. Existing uses of abutting properties: Residential
14. Date of construction of all buildings & structures on subject land: 2009
15. Length of time the existing uses of the subject property have been continued: Since Construction
16. (a) What water supply is existing/proposed?
Municipal ☒ Other (specify) _____
Well ☐
- (b) What sewage disposal is/will be provided?
Municipal ☒ Other (specify) _____
Septic ☐
- (c) What storm drainage system is existing/proposed?
Sewers ☒ Other (specify) _____
Ditches ☐
Swales ☐

17. Is the subject property the subject of an application under the Planning Act, for approval of a plan of subdivision or consent?

Yes ☐ No ☒

If answer is yes, provide details: File # _____ Status _____

18. Has a pre-consultation application been filed?

Yes ☐ No ☒

19. Has the subject property ever been the subject of an application for minor variance?

Yes ☐ No ☒ Unknown ☐

If answer is yes, provide details:

File # _____	Decision _____	Relief _____
File # _____	Decision _____	Relief _____
File # _____	Decision _____	Relief _____

Mehra Roma
Signature of Applicant(s) or Authorized Agent

DATED AT THE _____ City _____ OF _____ Brampton
THIS 27th DAY OF September, 2021

IF THIS APPLICATION IS SIGNED BY AN AGENT, SOLICITOR OR ANY PERSON OTHER THAN THE OWNER OF THE SUBJECT LANDS, WRITTEN AUTHORIZATION OF THE OWNER MUST ACCOMPANY THE APPLICATION. IF THE APPLICANT IS A CORPORATION, THE APPLICATION SHALL BE SIGNED BY AN OFFICER OF THE CORPORATION AND THE CORPORATION'S SEAL SHALL BE AFFIXED.

I, Vivek Mehra & Roma Mehra, OF THE City OF Brampton
IN THE Province OF Ontario SOLEMNLY DECLARE THAT:

ALL OF THE ABOVE STATEMENTS ARE TRUE AND I MAKE THIS SOLEMN DECLARATION CONSCIENTIOUSLY BELIEVING IT TO BE TRUE AND KNOWING THAT IT IS OF THE SAME FORCE AND EFFECT AS IF MADE UNDER OATH.





DECLARED BEFORE ME AT THE
City OF Brampton
IN THE Region OF _____
THIS 27th DAY OF Sept., 2021
Jeanie Myers
A Commissioner etc.

Mehra Roma
Signature of Applicant or Authorized Agent


Jeanie Cecilia Myers
a Commissioner, etc.,
Province of Ontario
for the Corporation of the
City of Brampton
Expires April 8, 2024.

FOR OFFICE USE ONLY	
Present Official Plan Designation:	_____
Present Zoning By-law Classification:	<u>R3B-SECTION 1315</u>
This application has been reviewed with respect to the variances required and the results of the said review are outlined on the attached checklist	
<u>J. Chau</u> Zoning Officer	<u>Sept 28, 2021</u> Date

DATE RECEIVED September 27, 2021.


LEGEND	
	GRASS
	EXISTING DRIVEWAY
	ASBUILT EXTENSION
	GRAVEL

MINOR VARIANCE APPLICATION
SIDE YARD ENTRANCE (PERSONAL USE) WITHOUT A UNOBSTRUCTED 1.2m PATH OF TRAVEL
MAXIMUM DRIVEWAY WIDTH, PROPOSED 5.35m DRIVEWAY WIDTH.

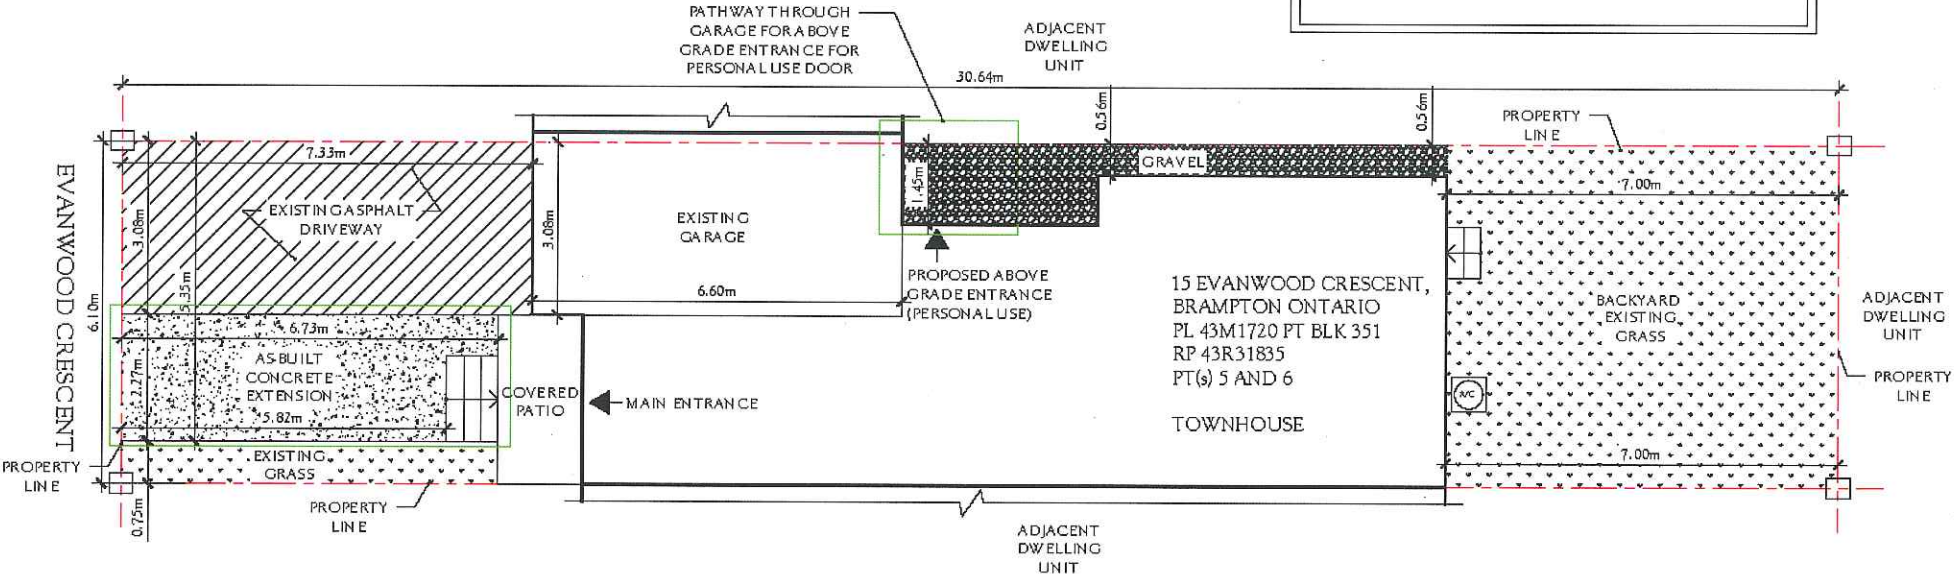

1 SITE PLAN
A101 SCALE: 1:100

NOTES:

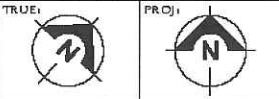

PROJECT TITLE: 15 EVANWOOD CRESCENT	
DRAWING TITLE: SITE PLAN	
SCALE: 1:100	DATE: 2021/09/23
DESIGNED BY: SINGH D. MARTINS R.	REVISION: 0
PROJECT NO. -	SHEET NO. A-101

C2

Mount Pleasant
Village Community
Centre & Library

A-2021-0229

a

b

B3

c

d

e

D3

